




街区面積 2949.83
 画地面積 2949.80
 差 0.03

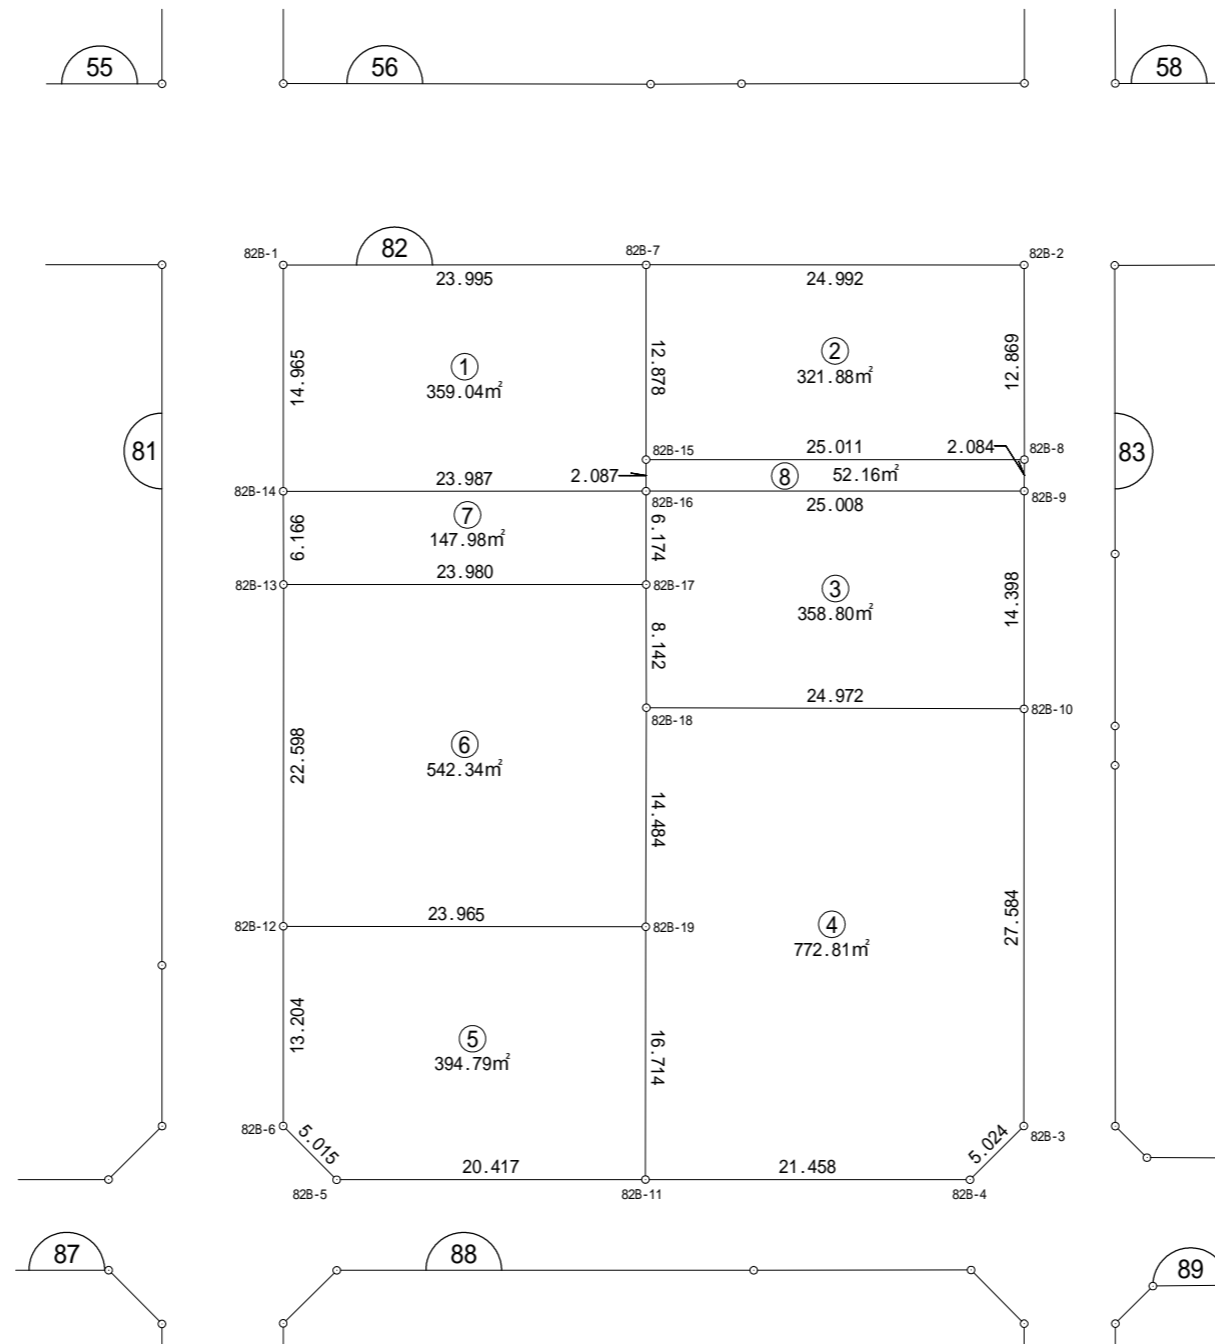

街区面積 1932.85

画地面積 1932.83



差 0.02

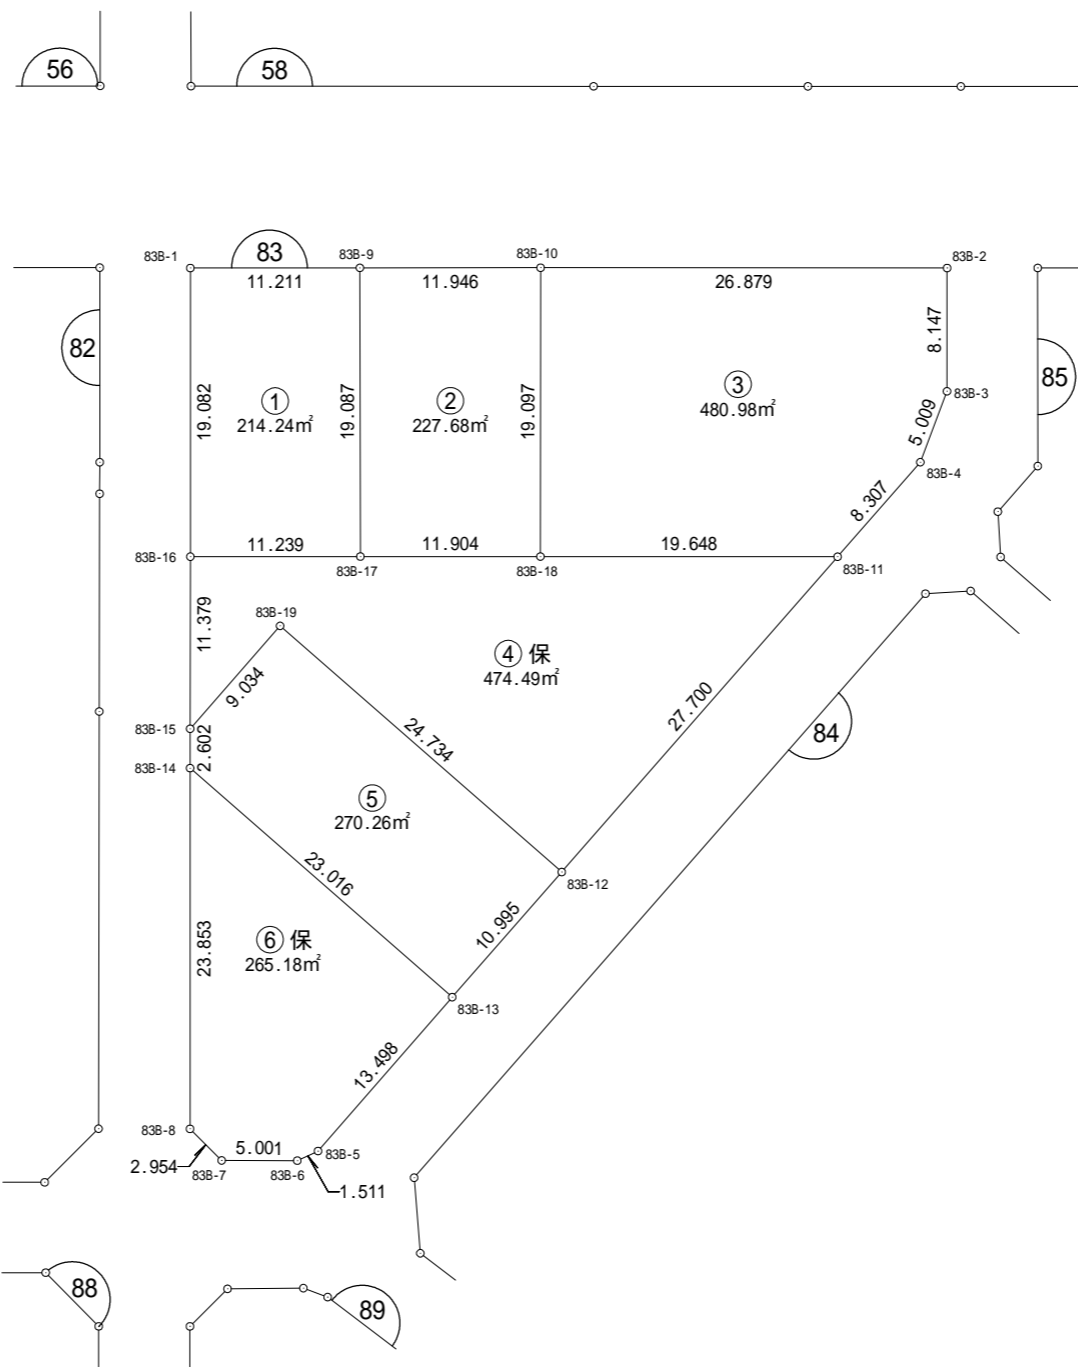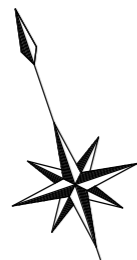

街区面積 4439.39

画地面積 4439.39

差 0.00

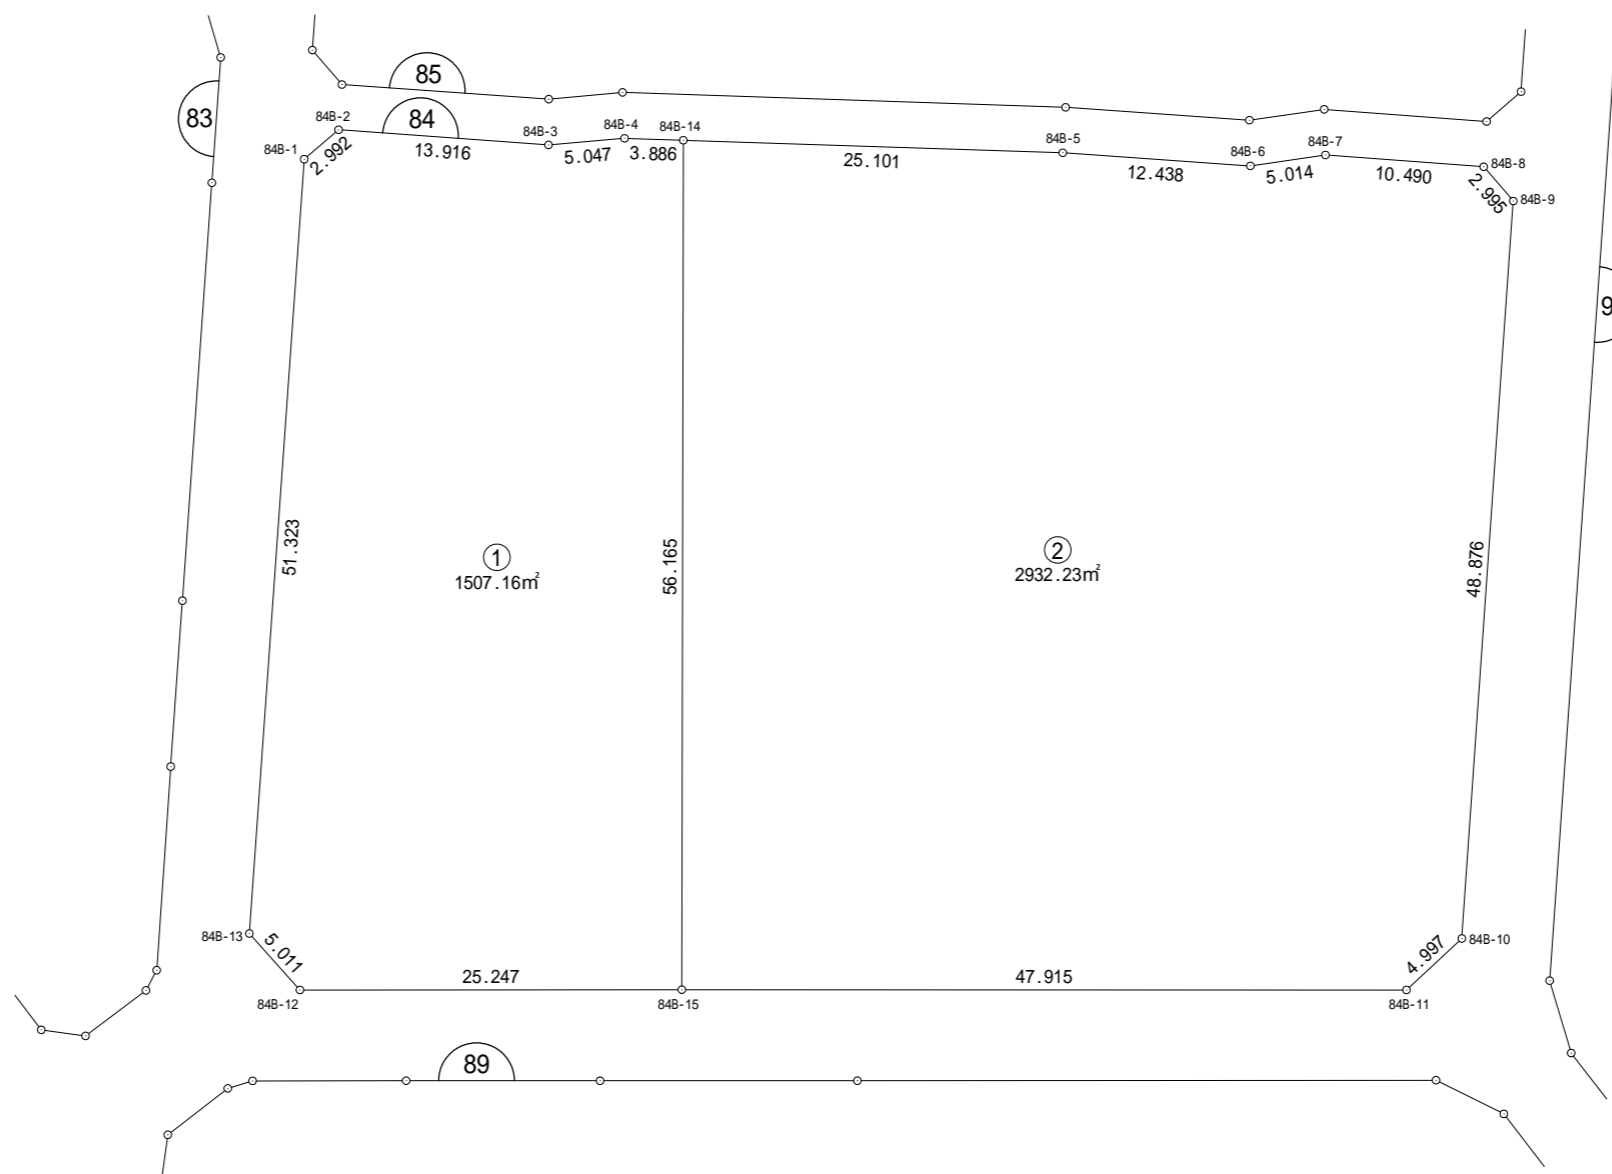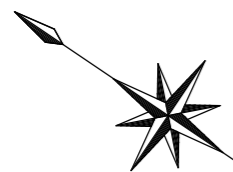




街区面積 4418.38

画地面積 4418.34


差 0.04

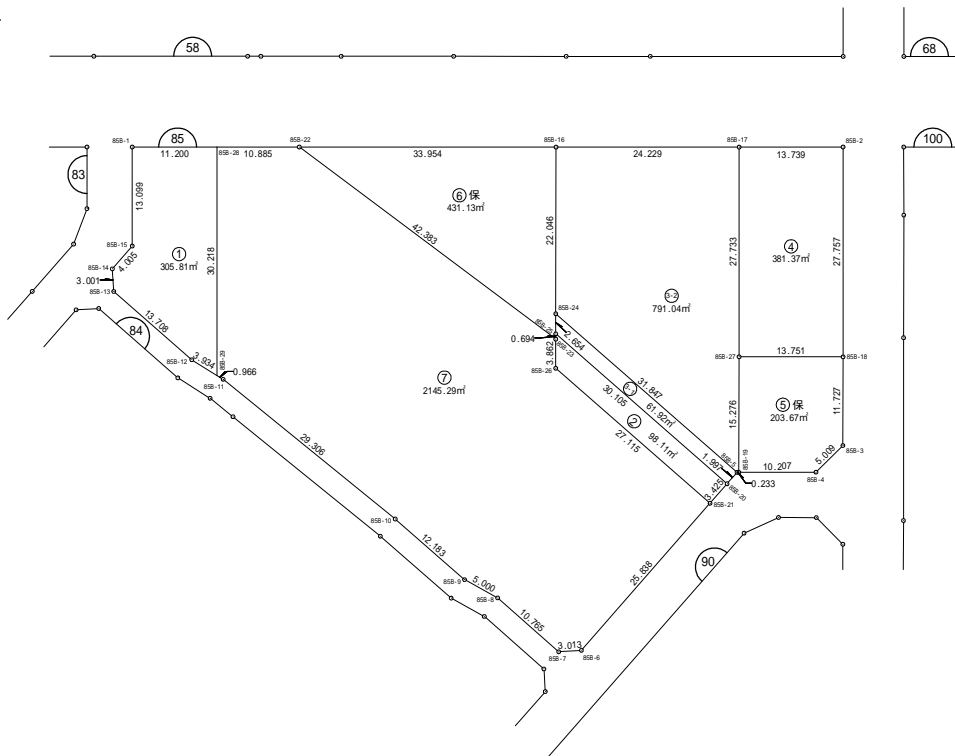


街区面積 3755.64

画地面積 3755.61

差 0.03

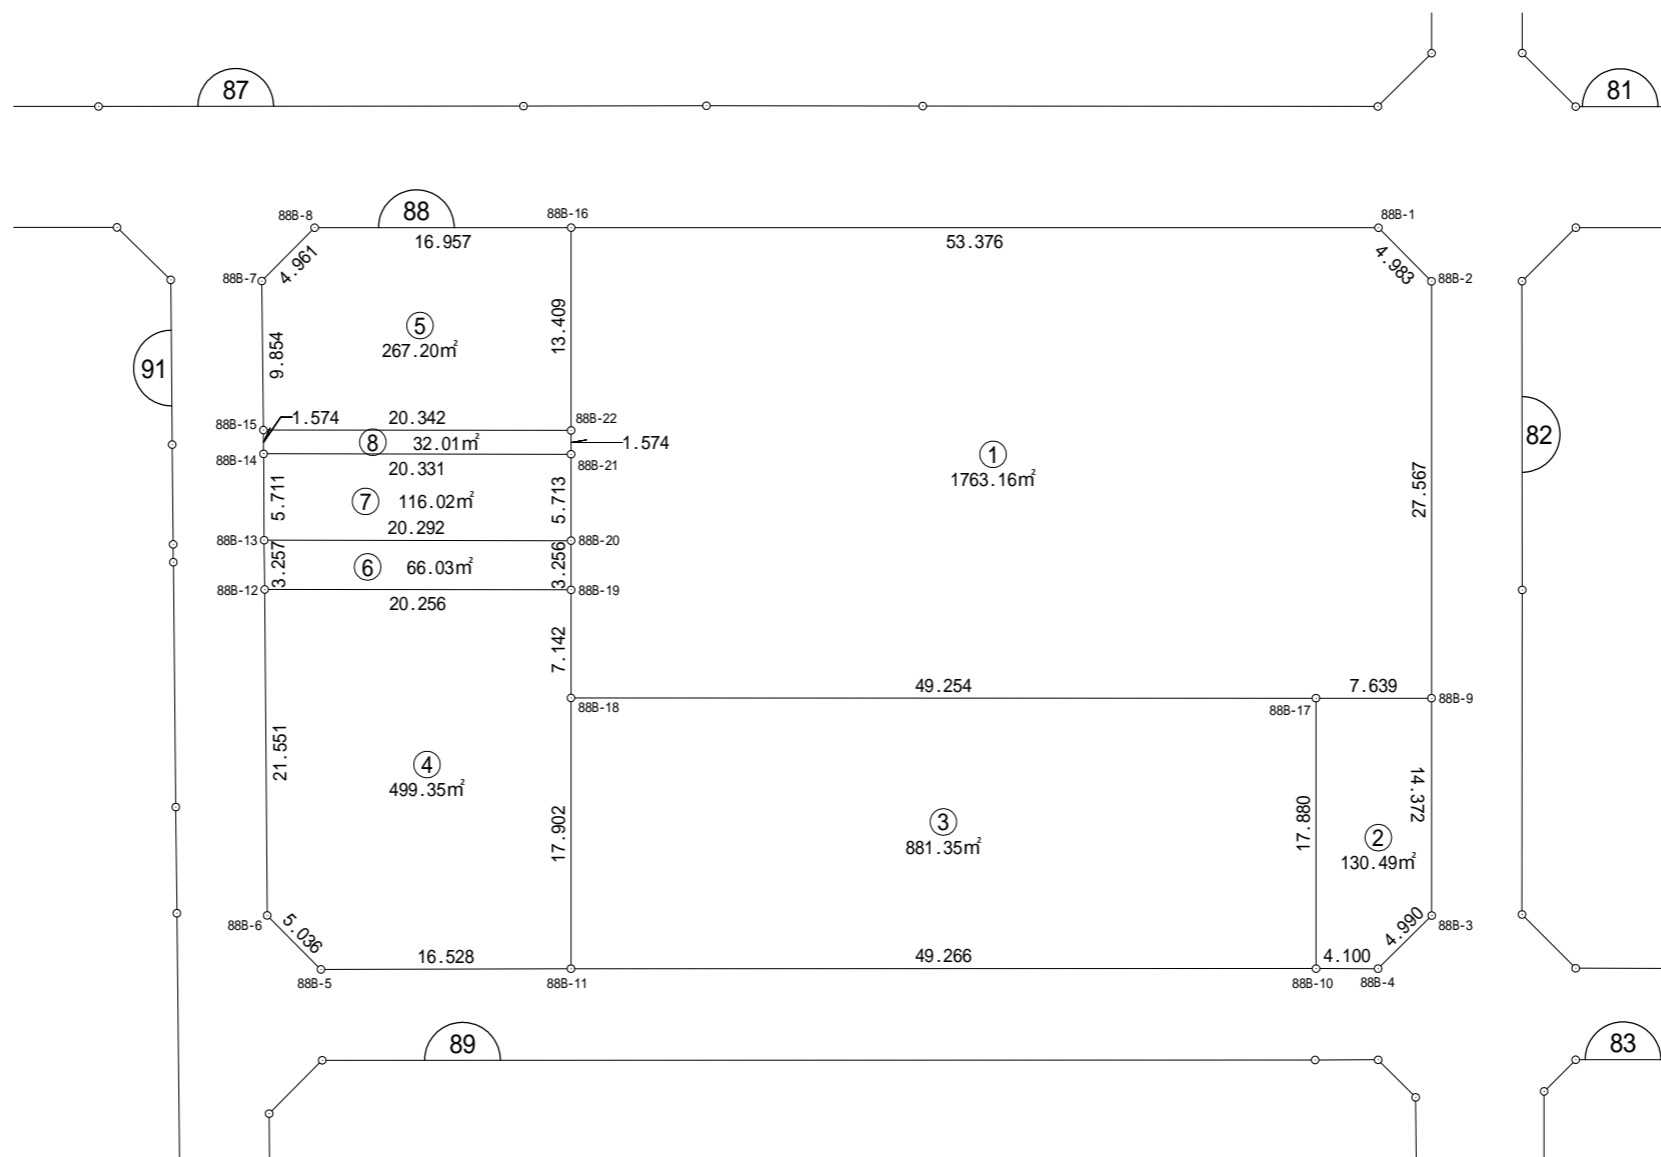


街区面積 3935.54
 画地面積 3935.52
 差 0.02

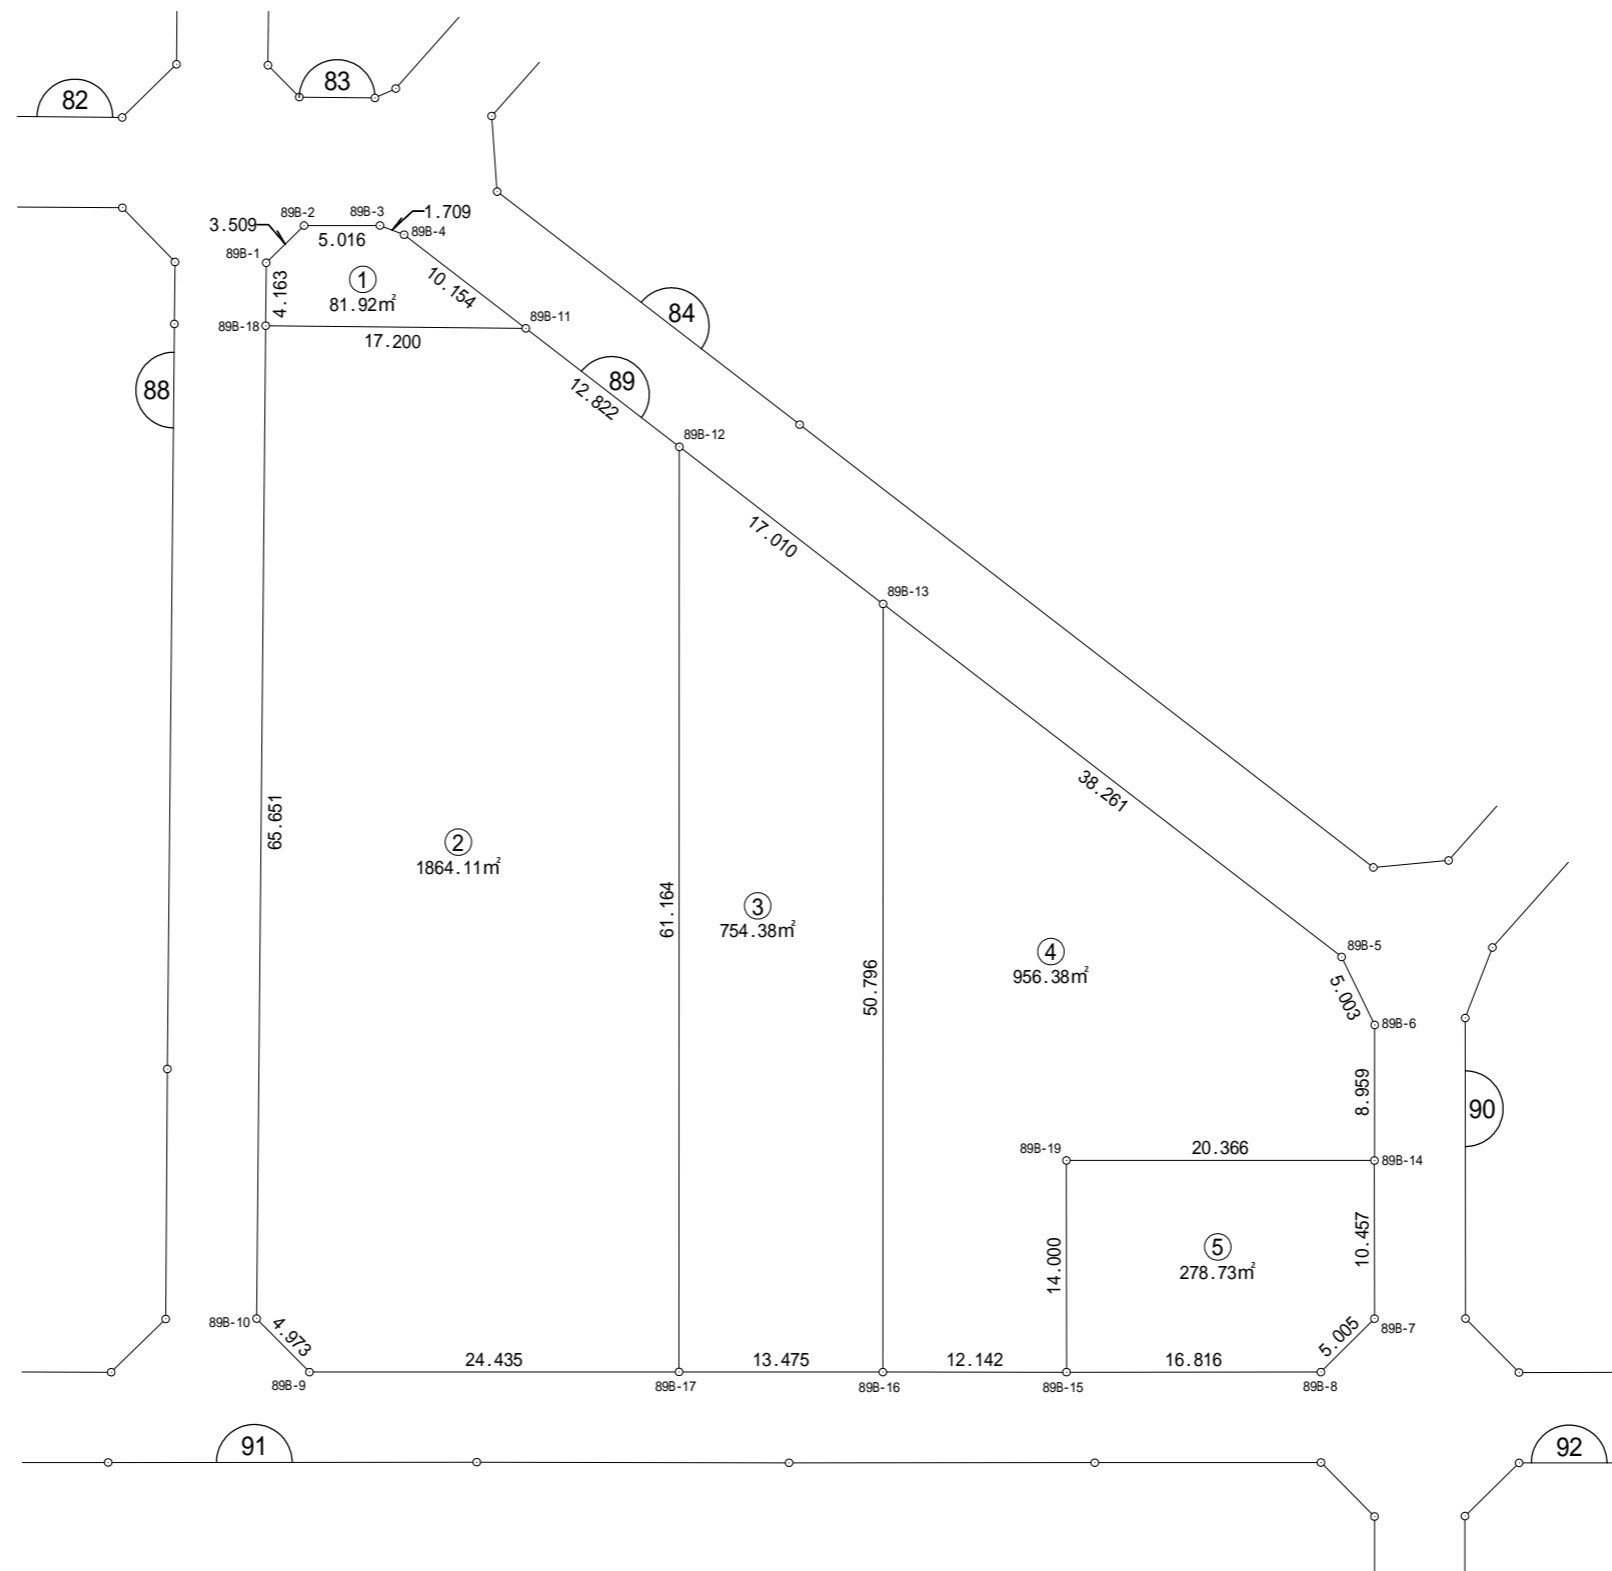




街区面積	4537.89
画地面積	4537.87
差	0.02

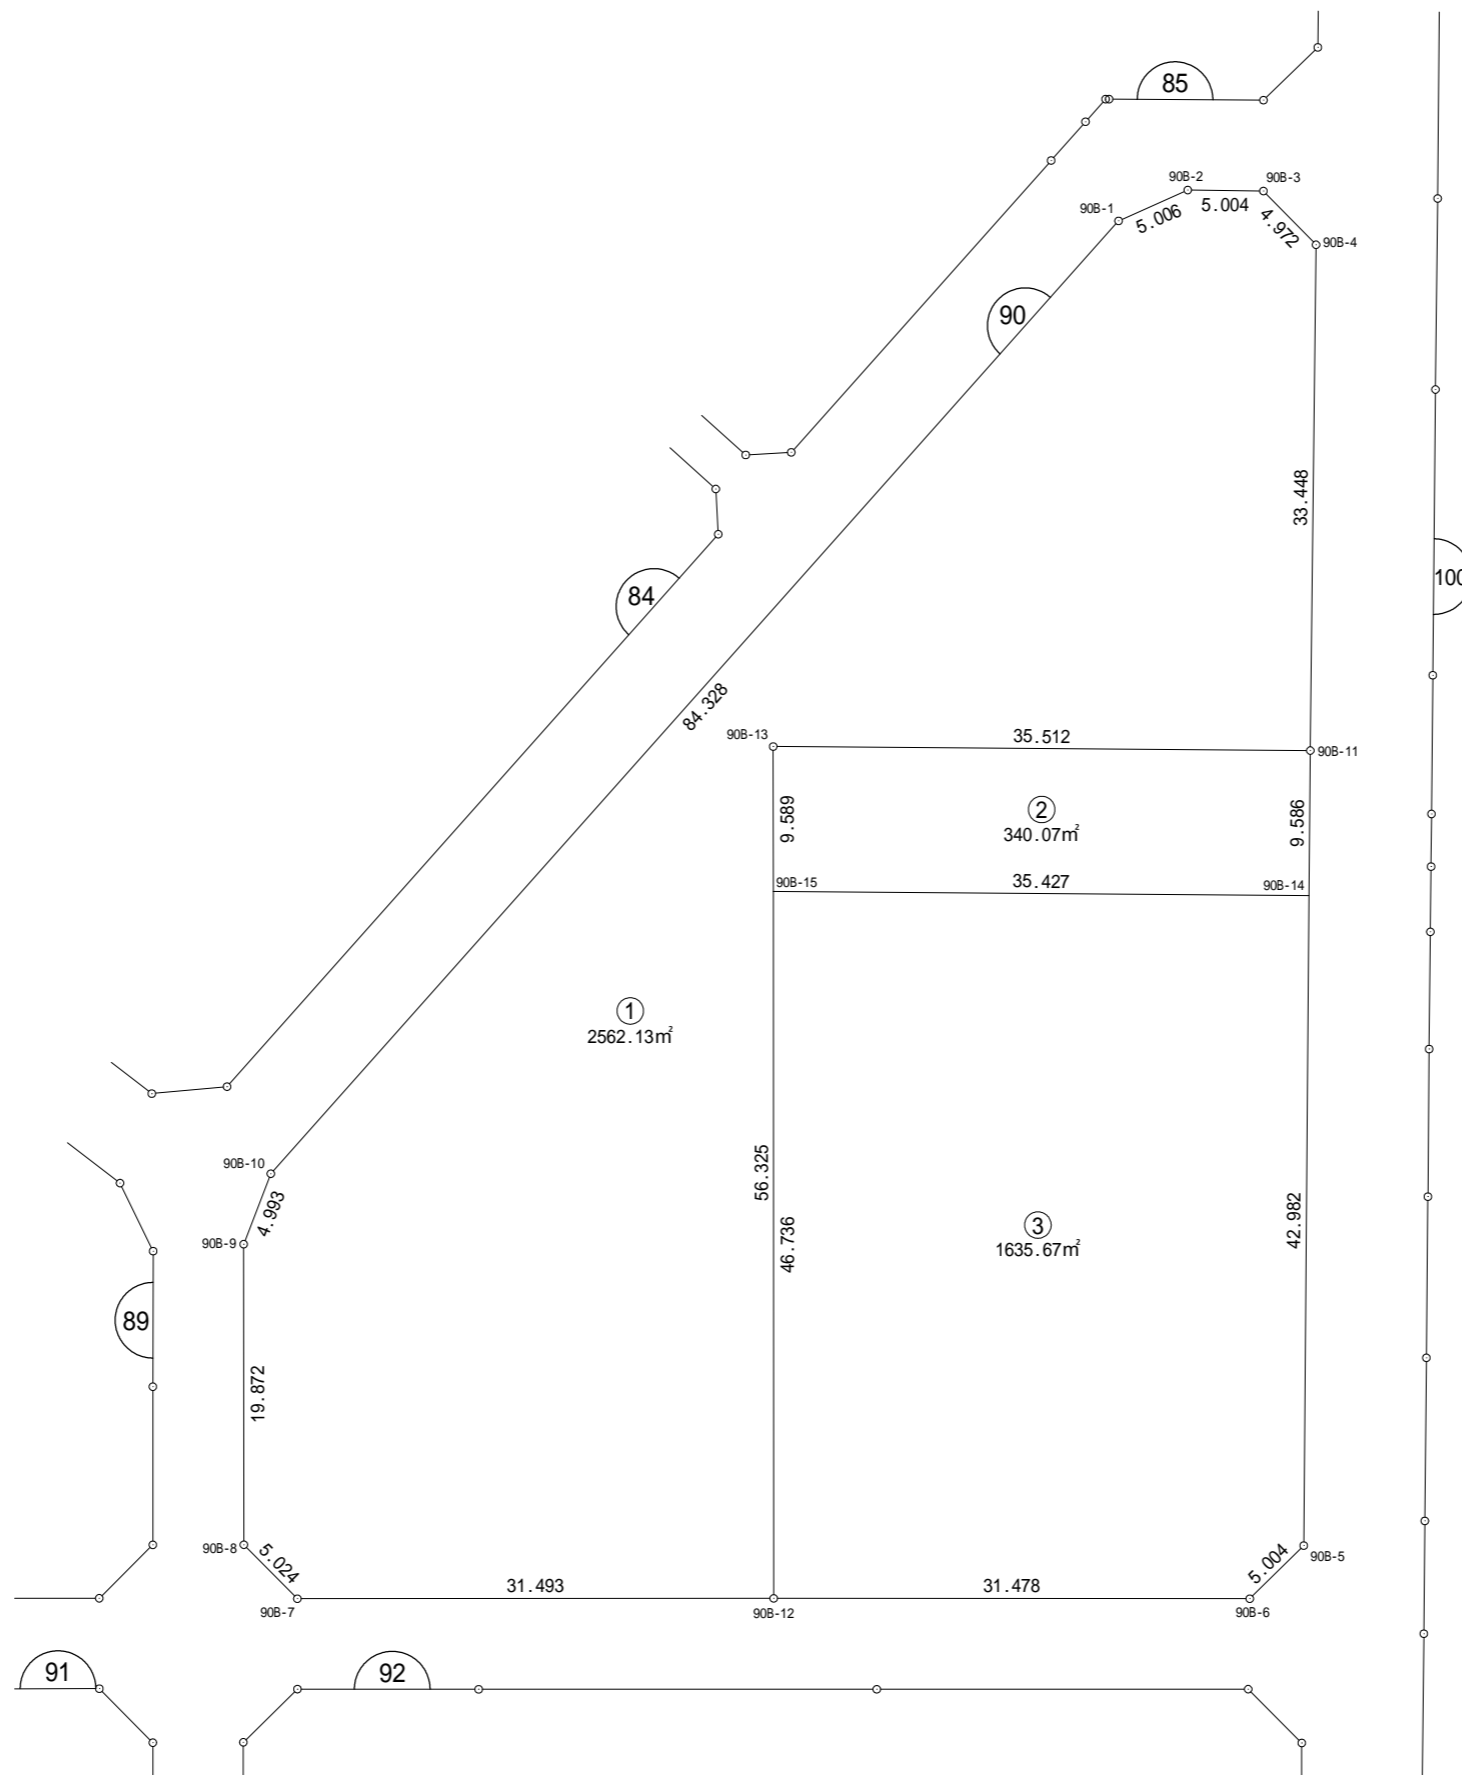

街区面積 5274.35

画地面積 5274.28


差 0.07

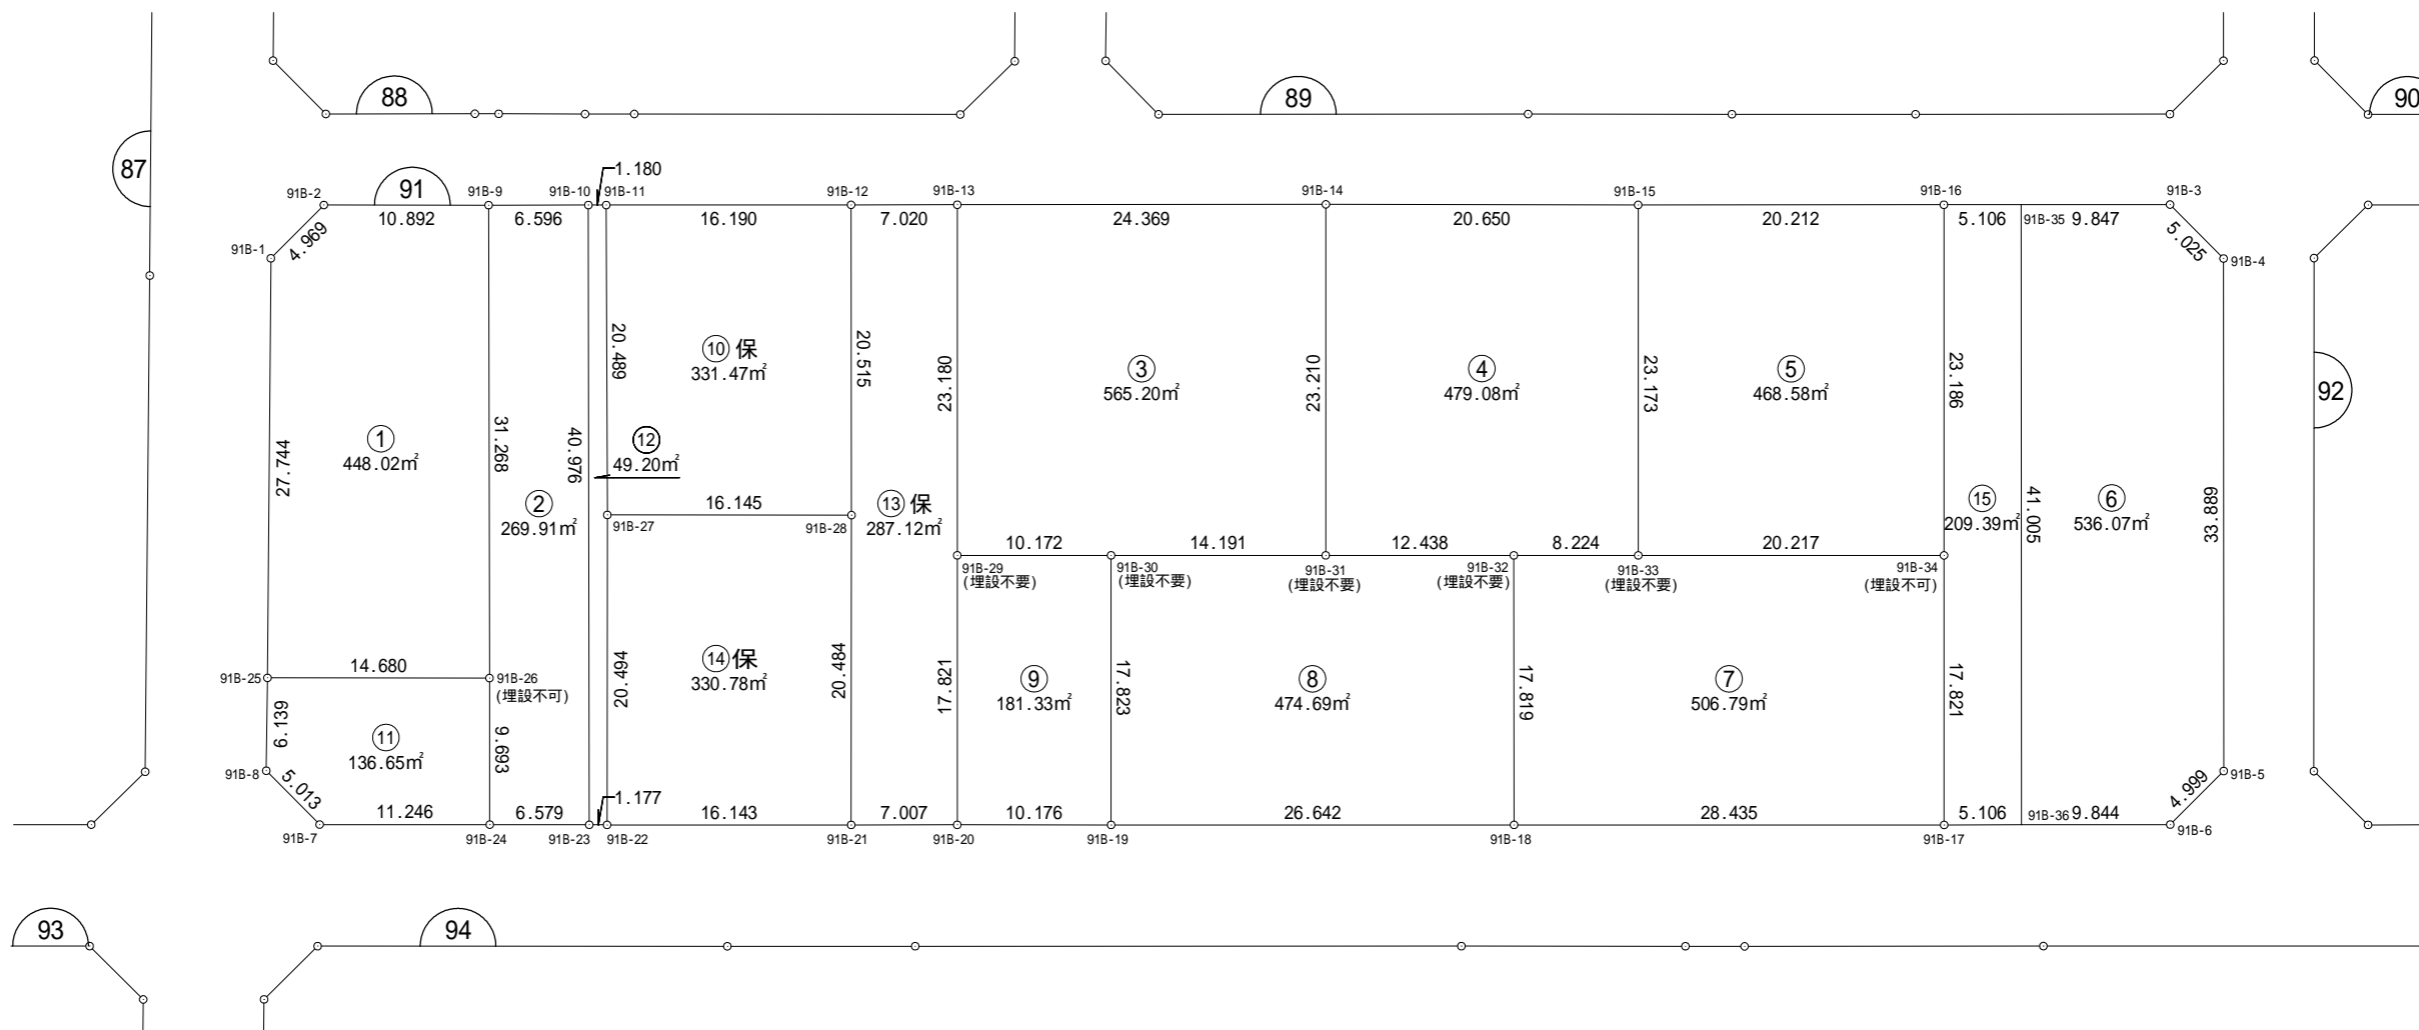

街区面積 2836.48

画地面積 2836.46


差 0.02

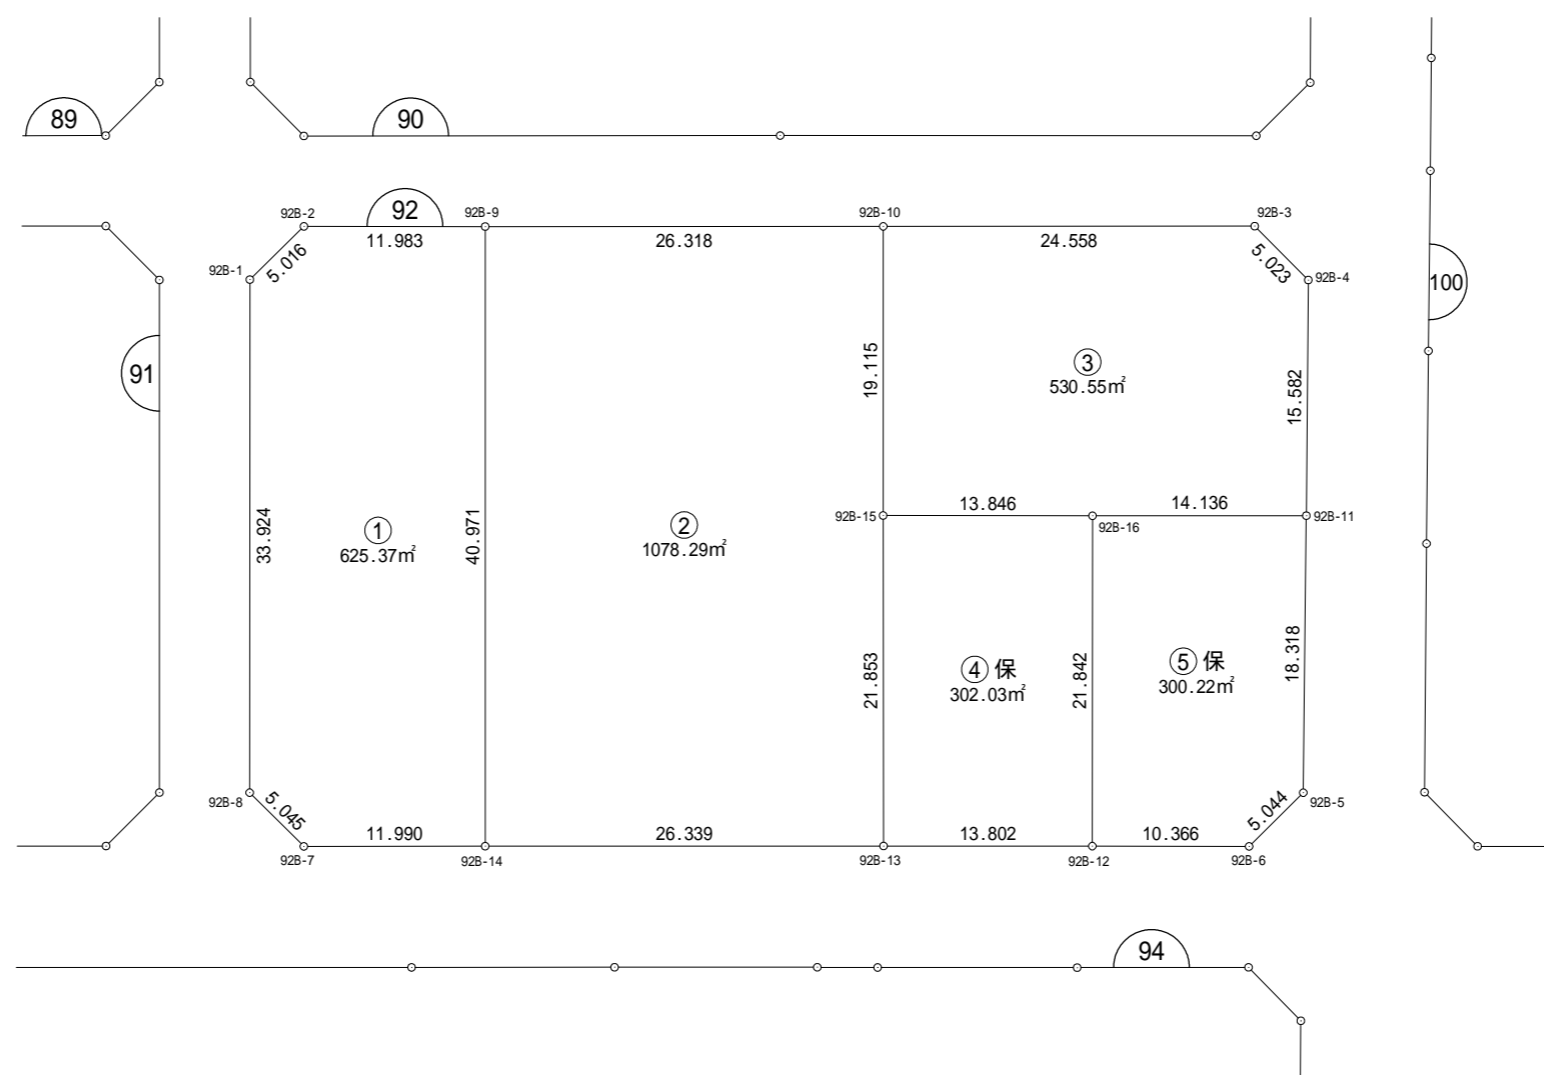

街区面積 10223.61

画地面積 10223.51


差 0.10

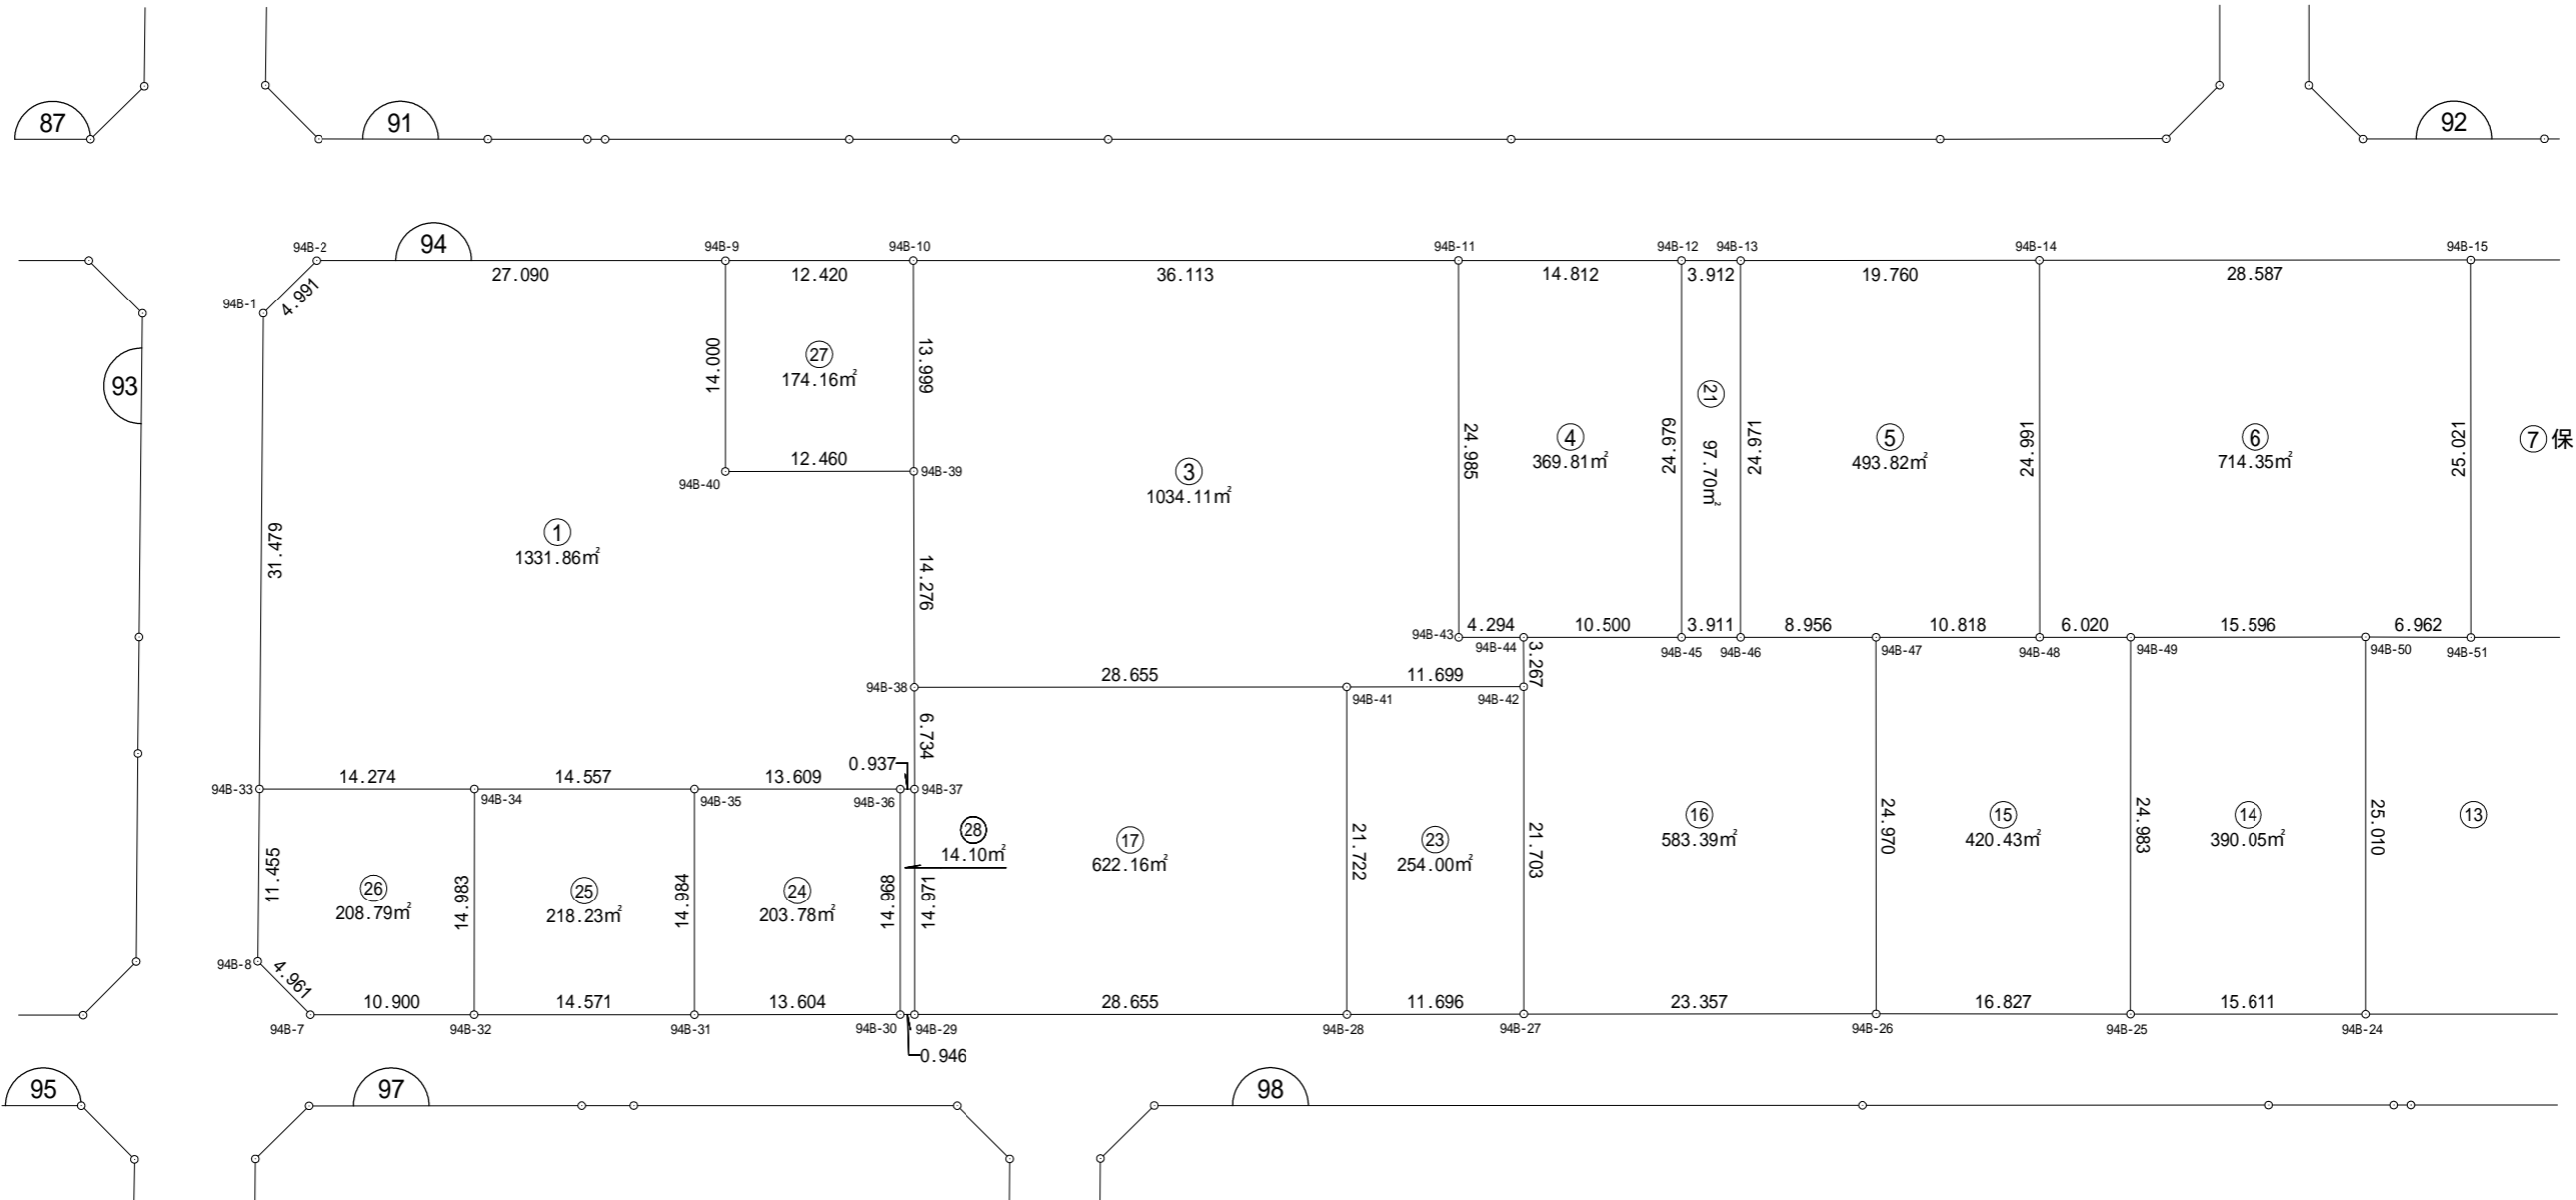

街区面積 10223.61

画地面積 10223.51


差 0.10

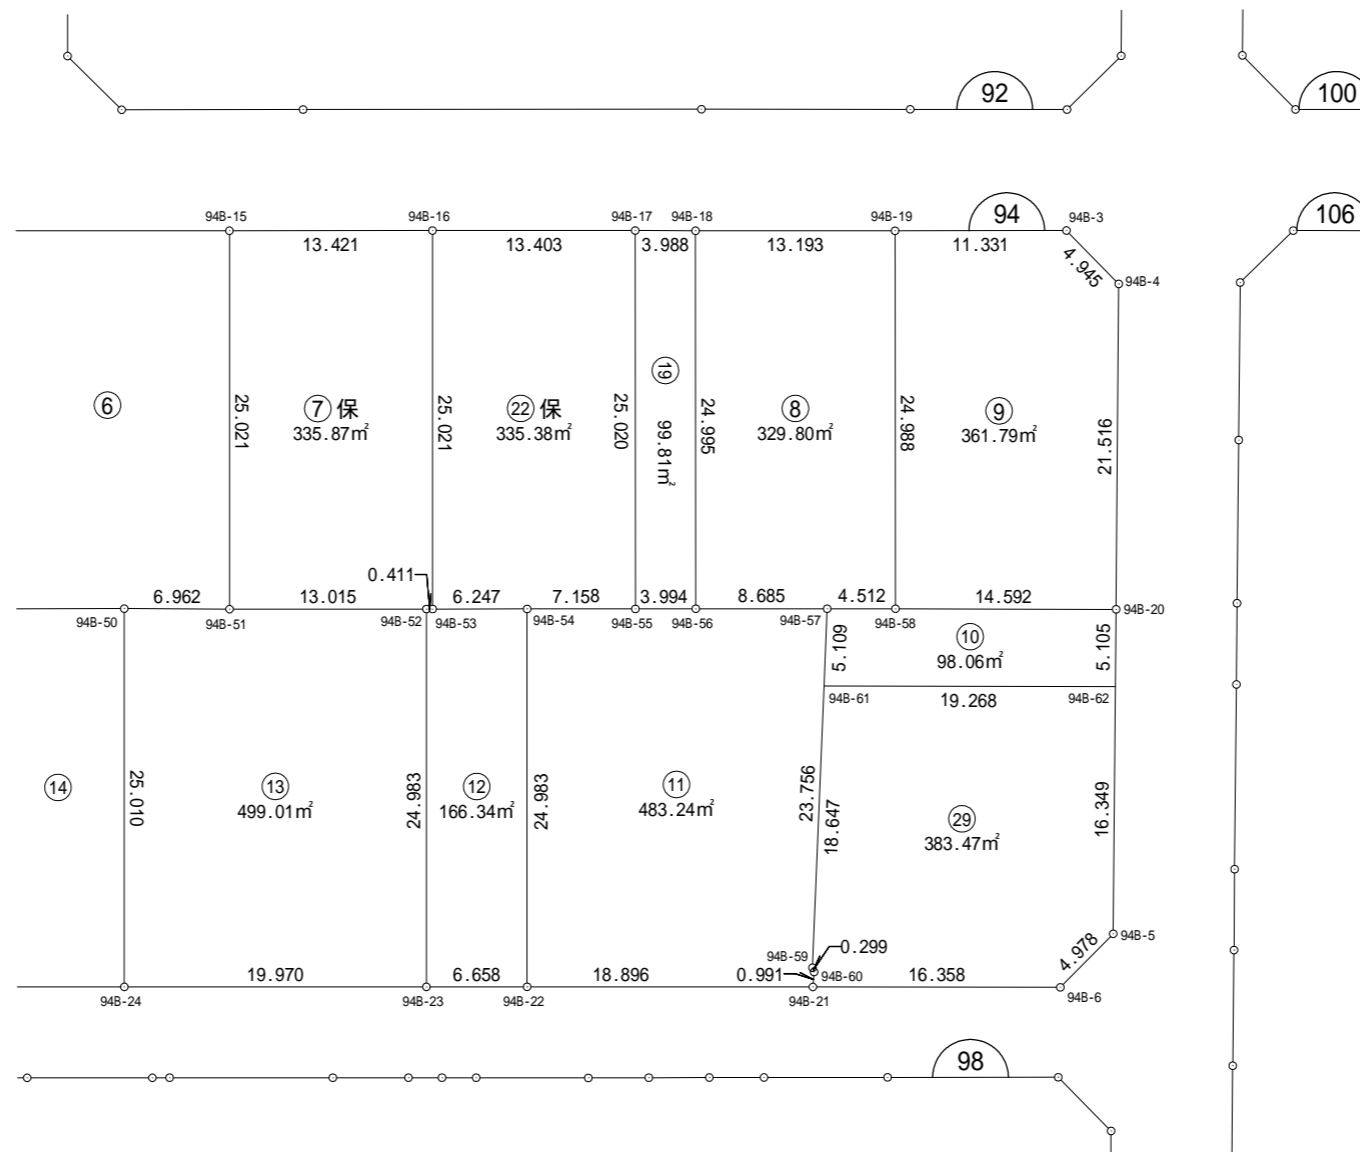

街区面積 4956.78

画地面積 4956.76


差 0.02

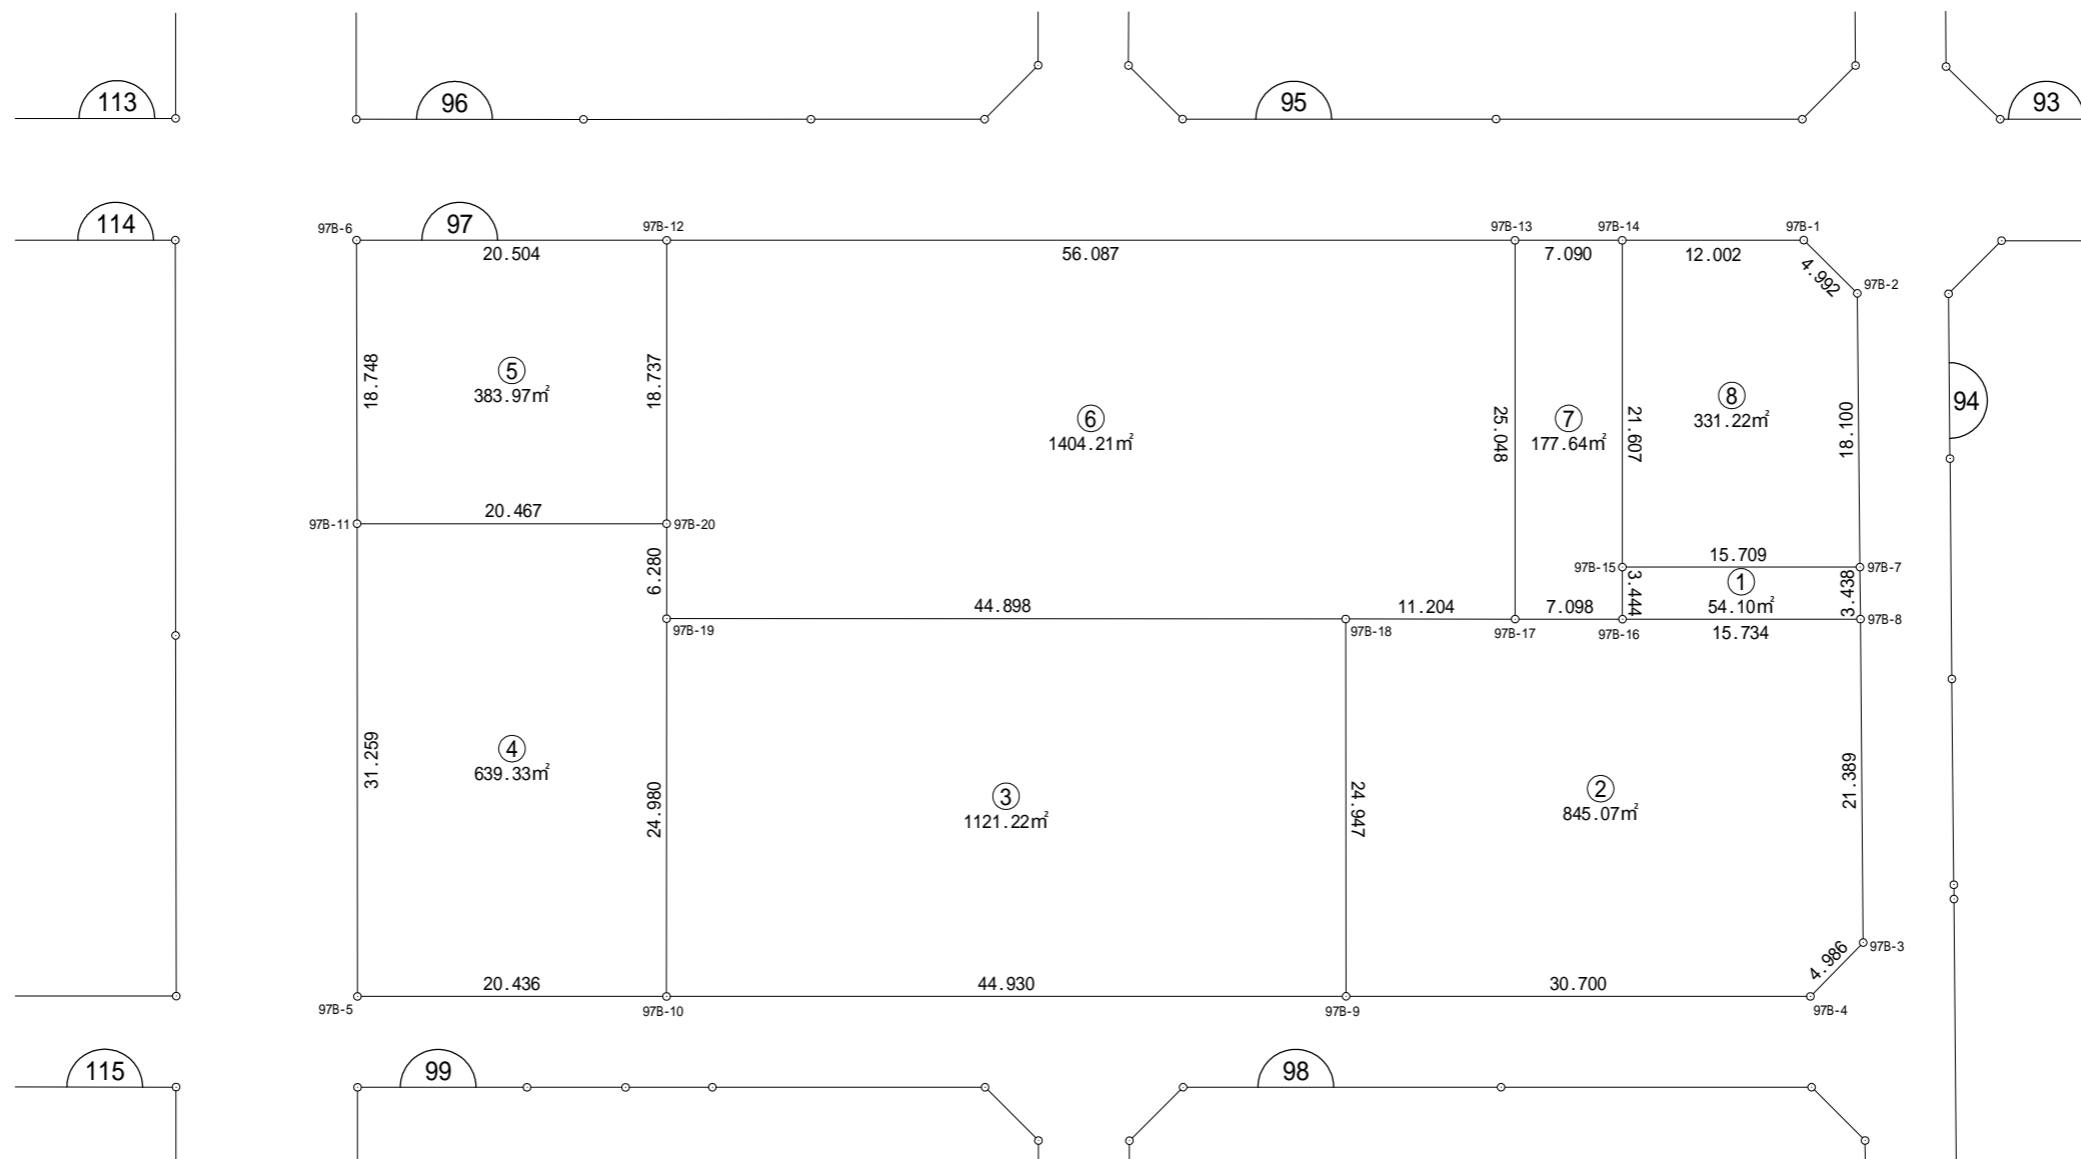

街区面積 7323.64

画地面積 7323.54


差 0.10

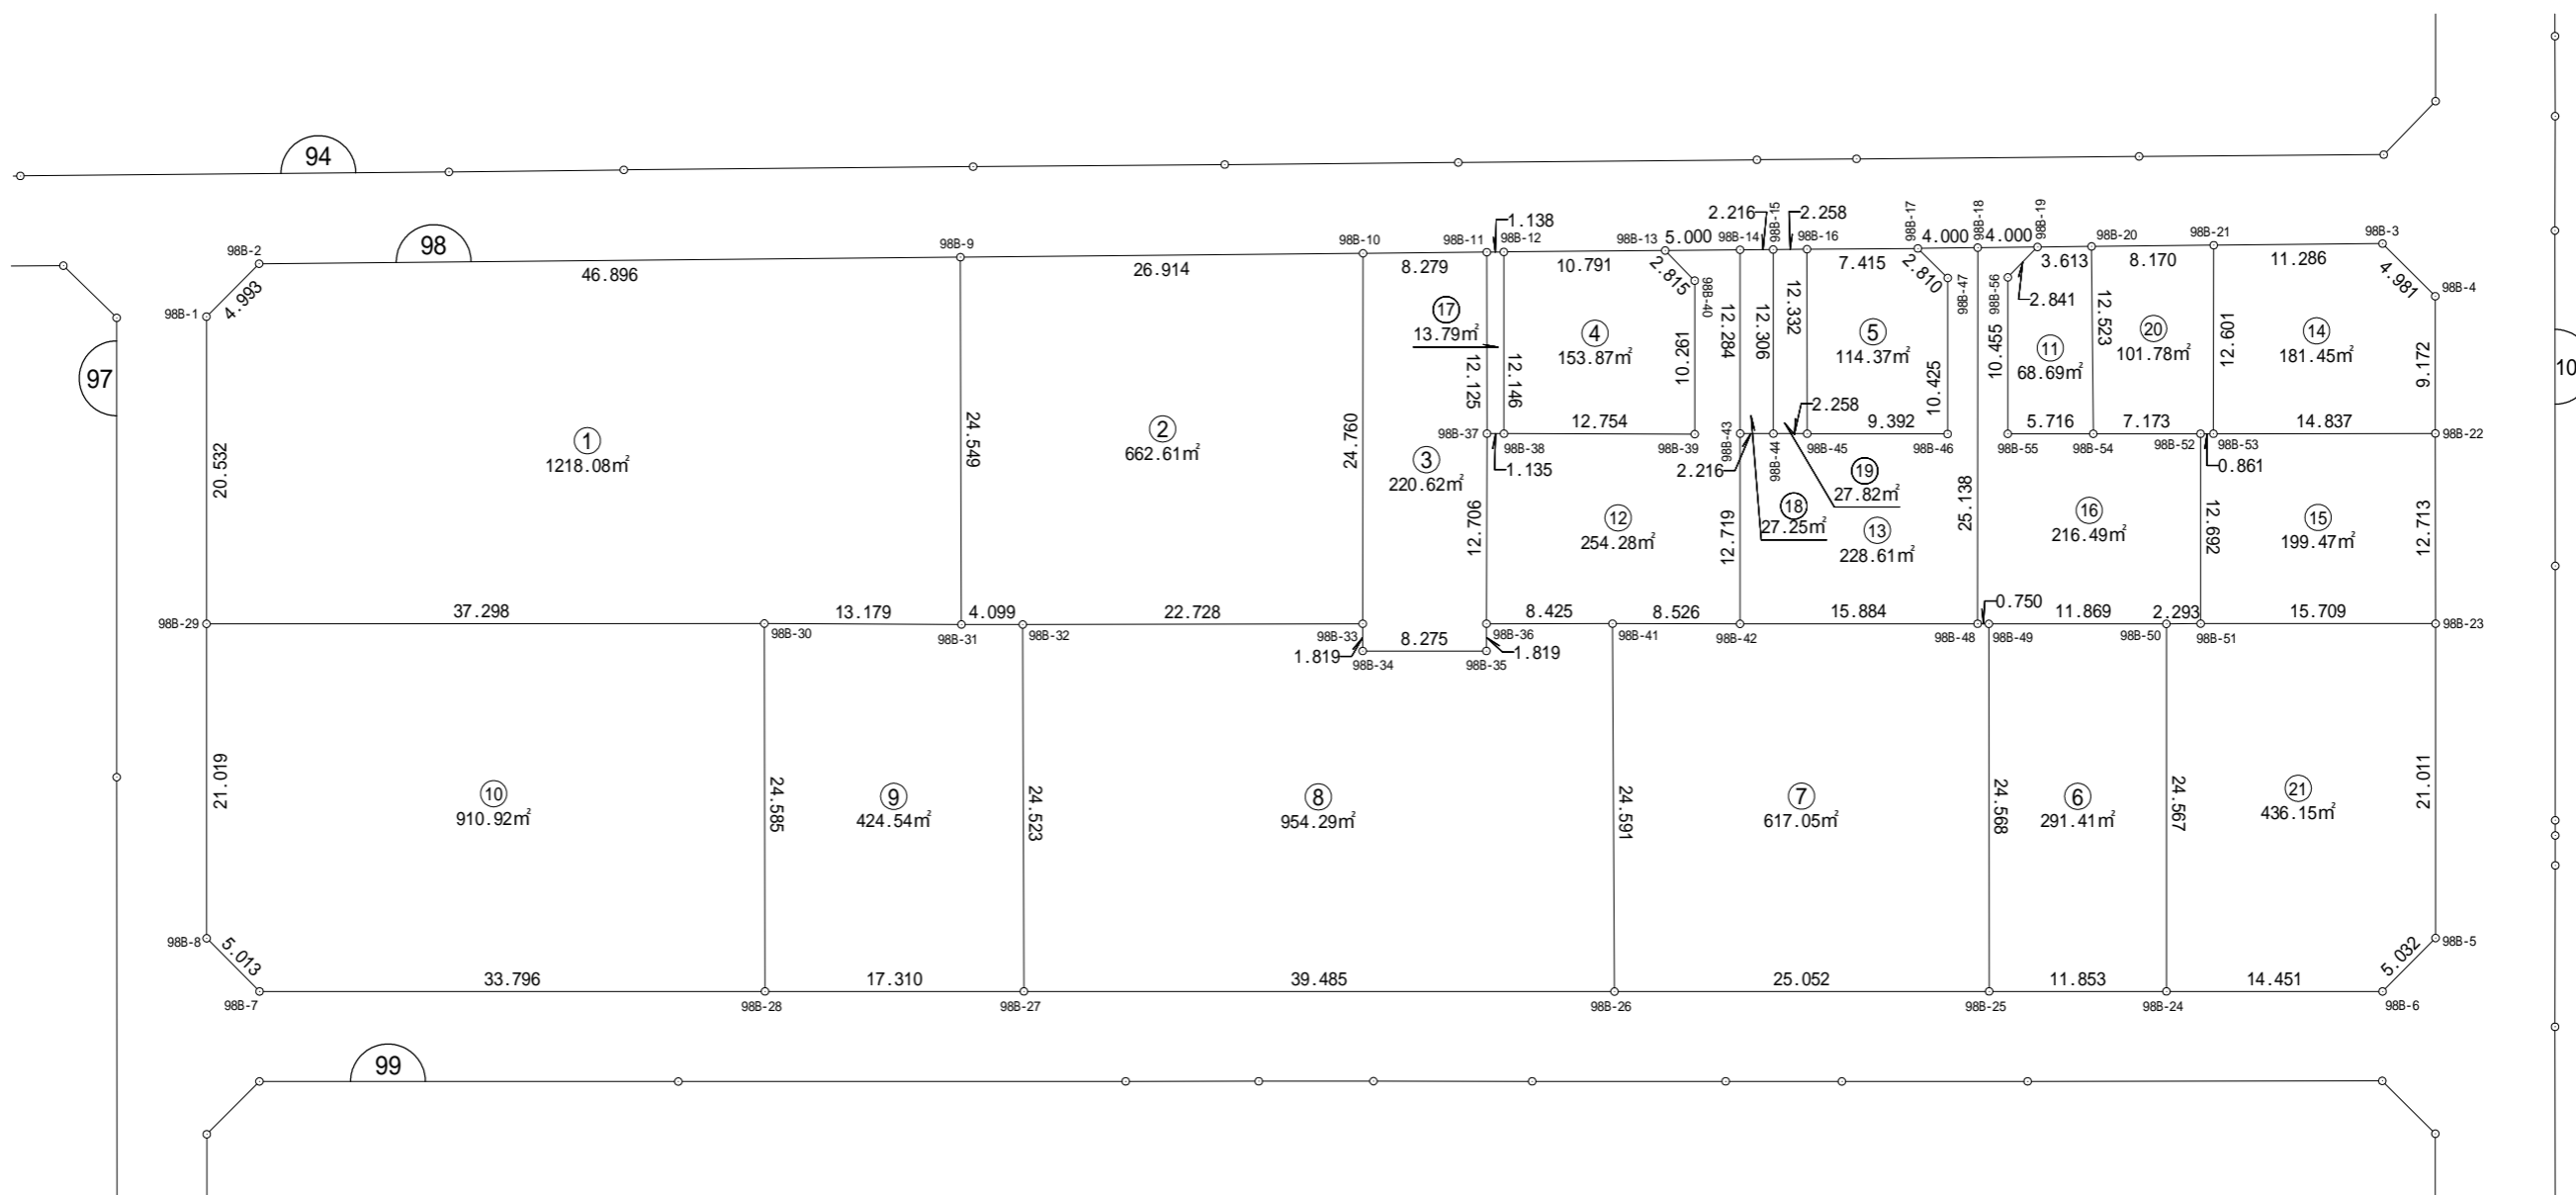

街区面積 6693.66

画地面積 6693.53


差 0.13

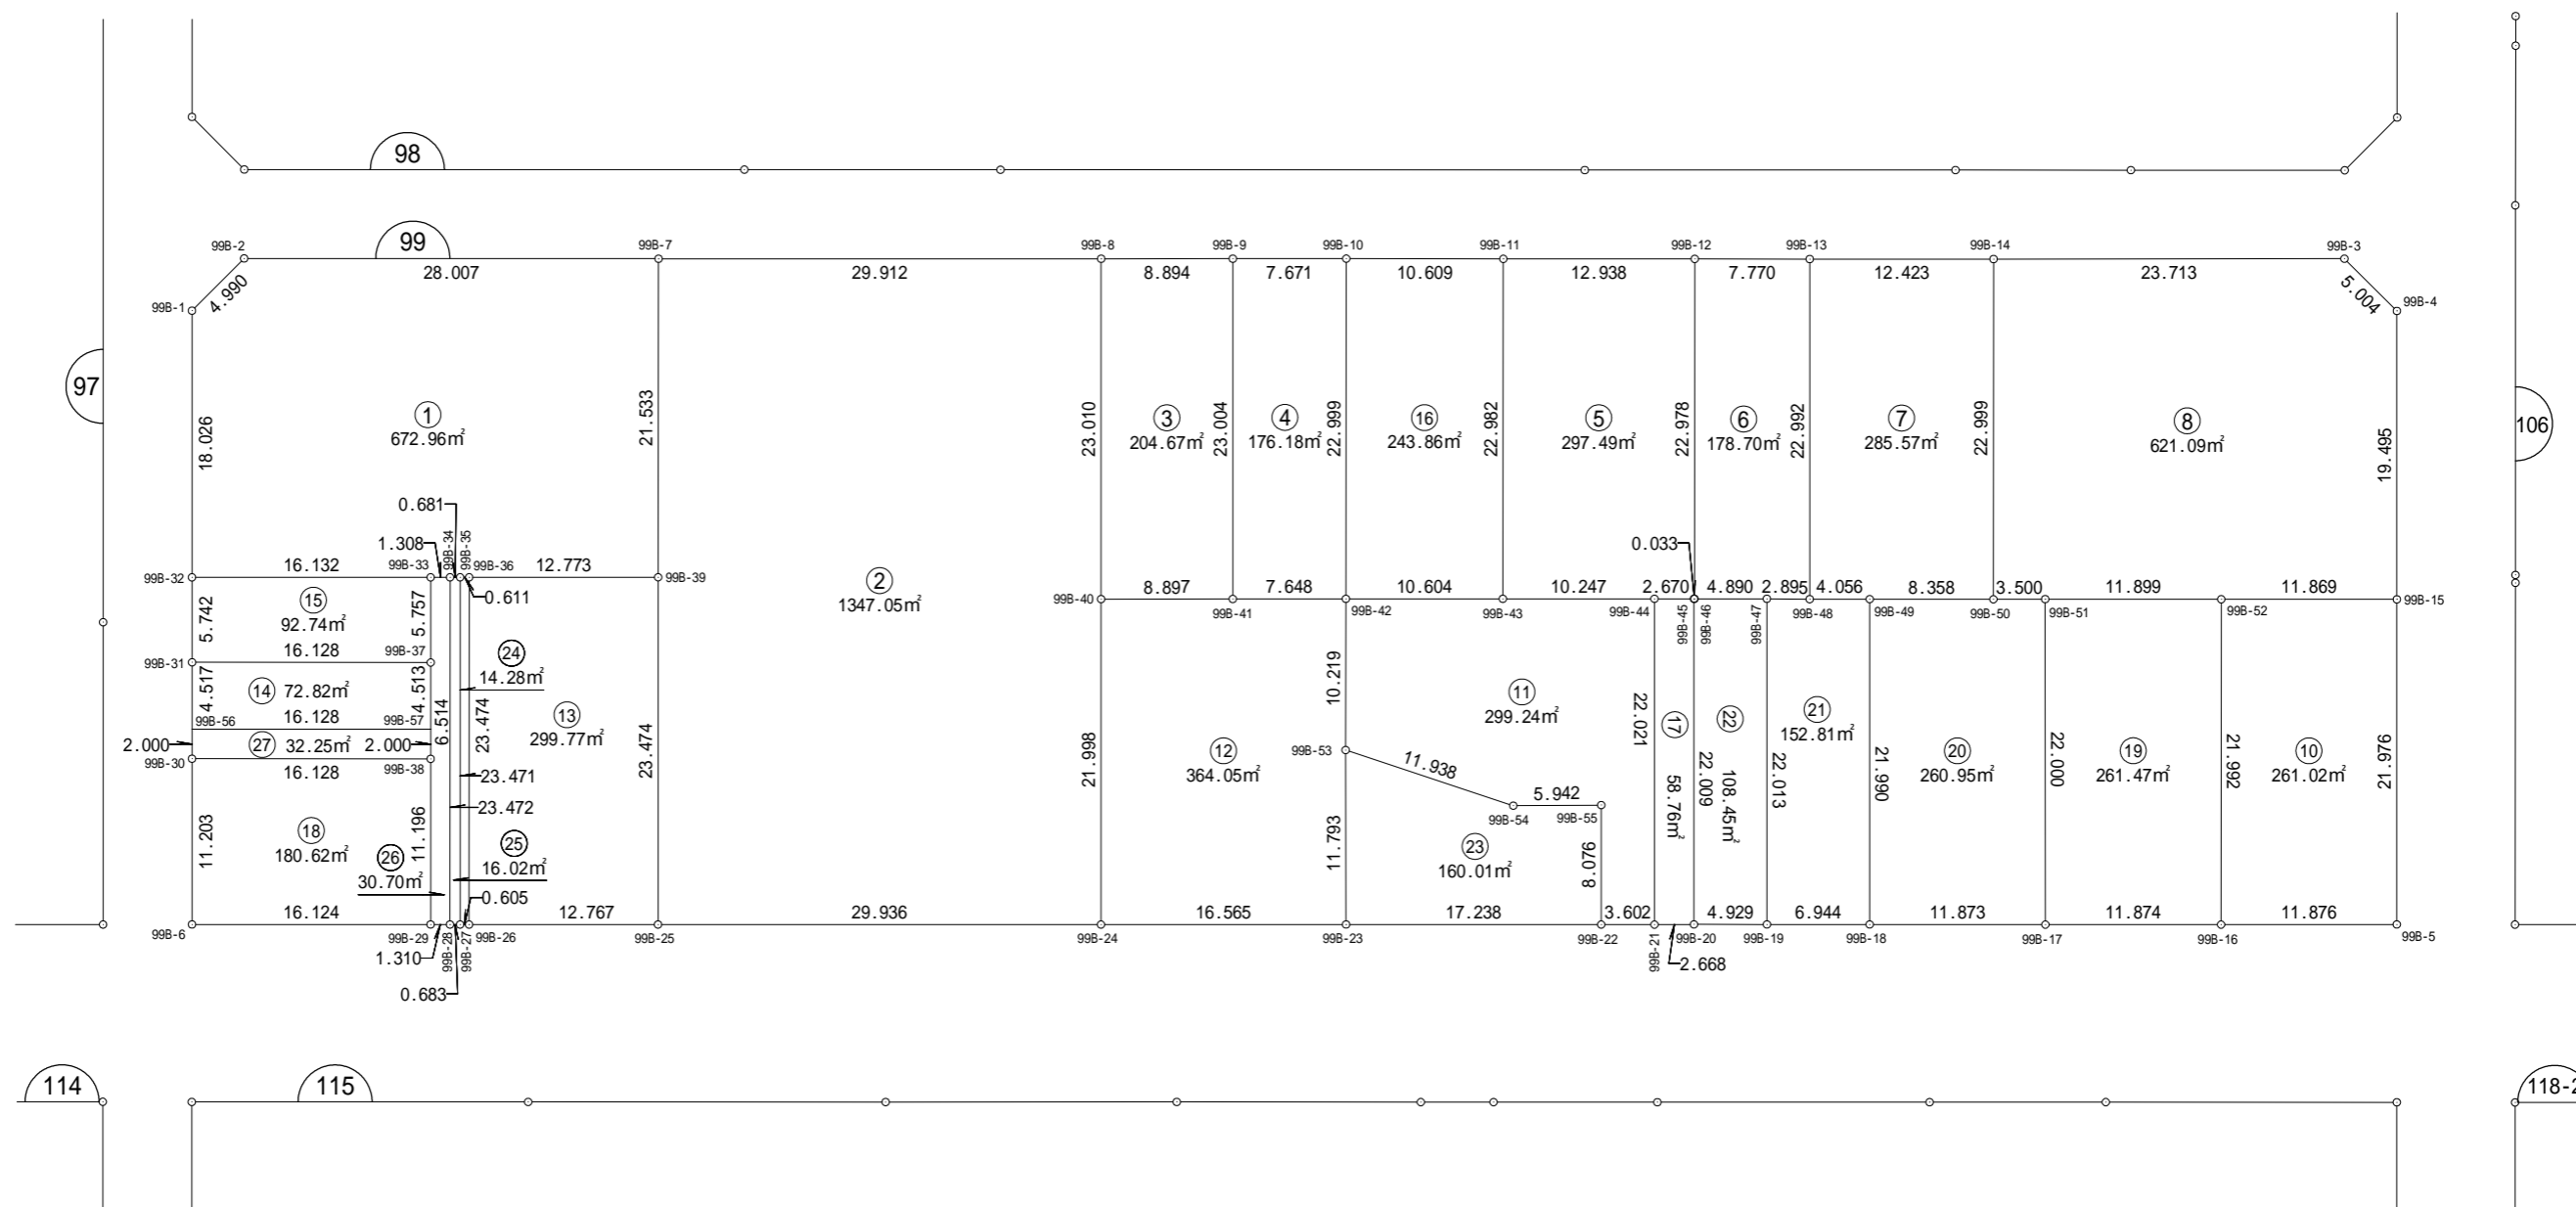

街区面積 9421.56

画地面積 9421.37


差 0.19

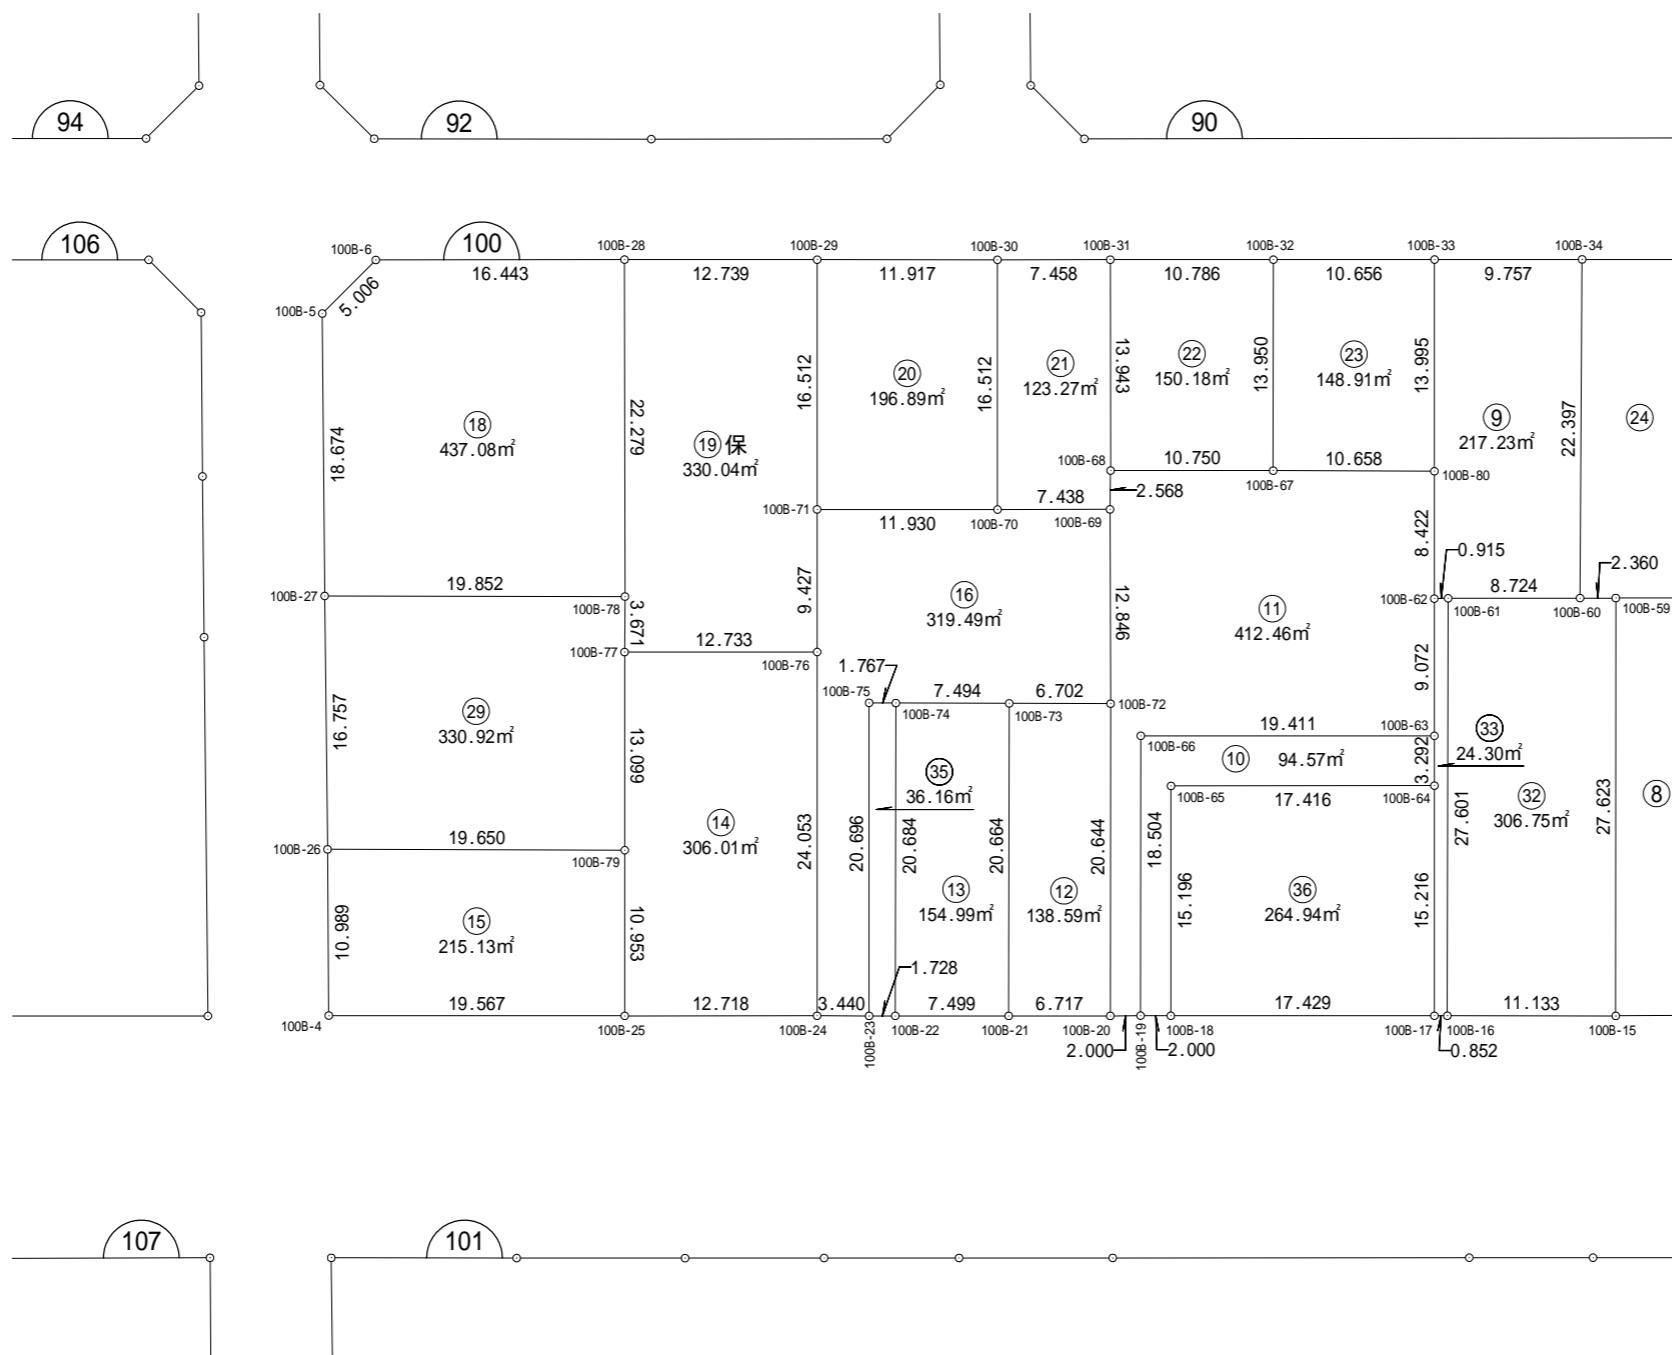

街区面積 9421.56

画地面積 9421.37


差 0.19

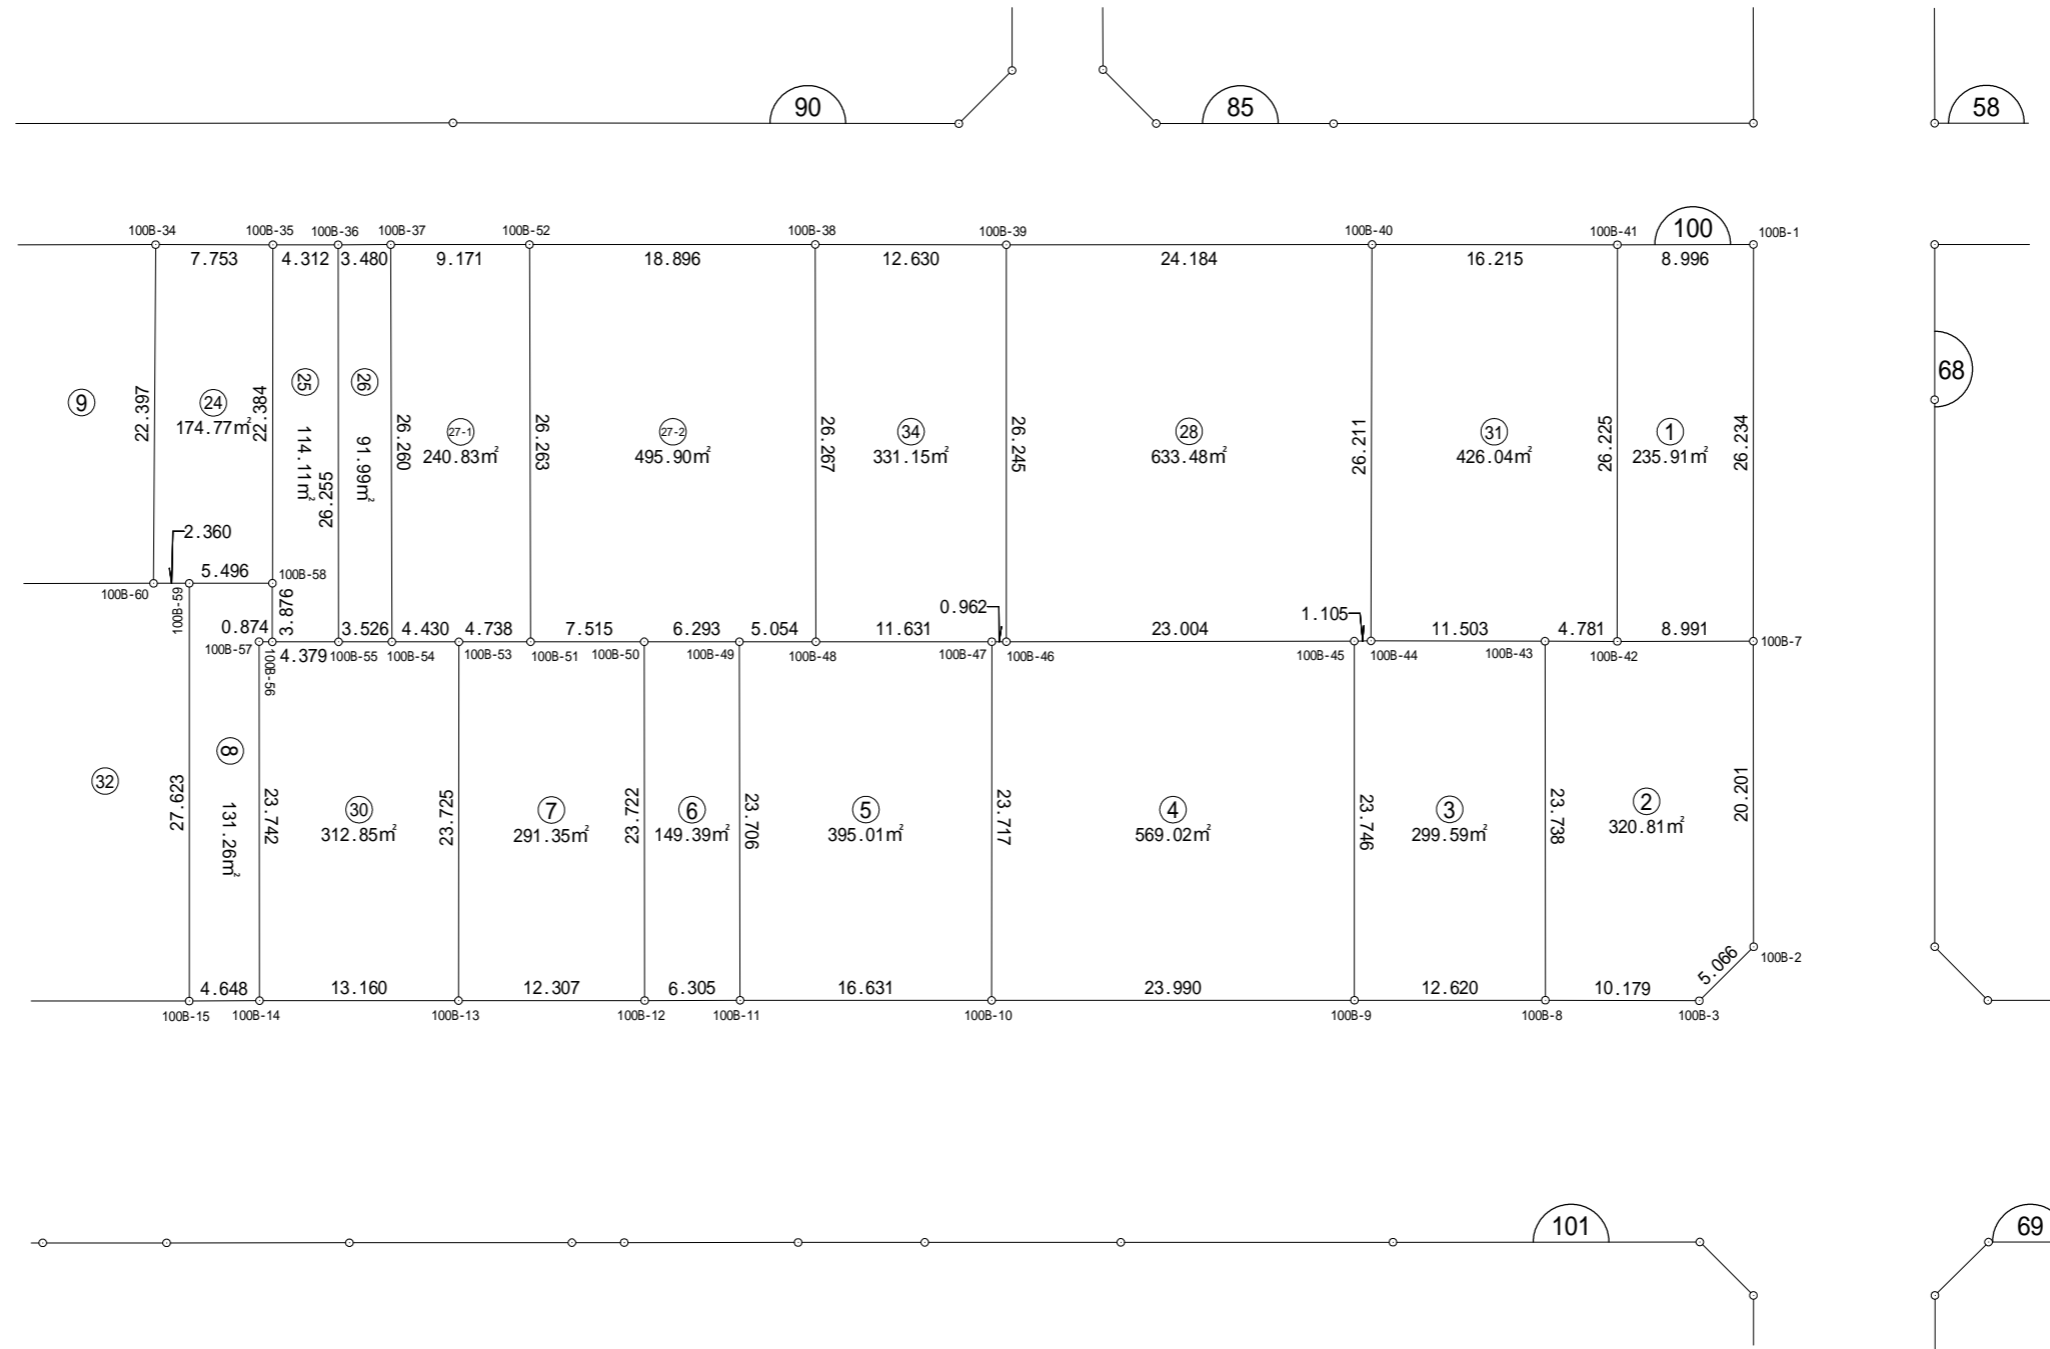

街区面積 7853.09

画地面積 7852.97


差 0.12

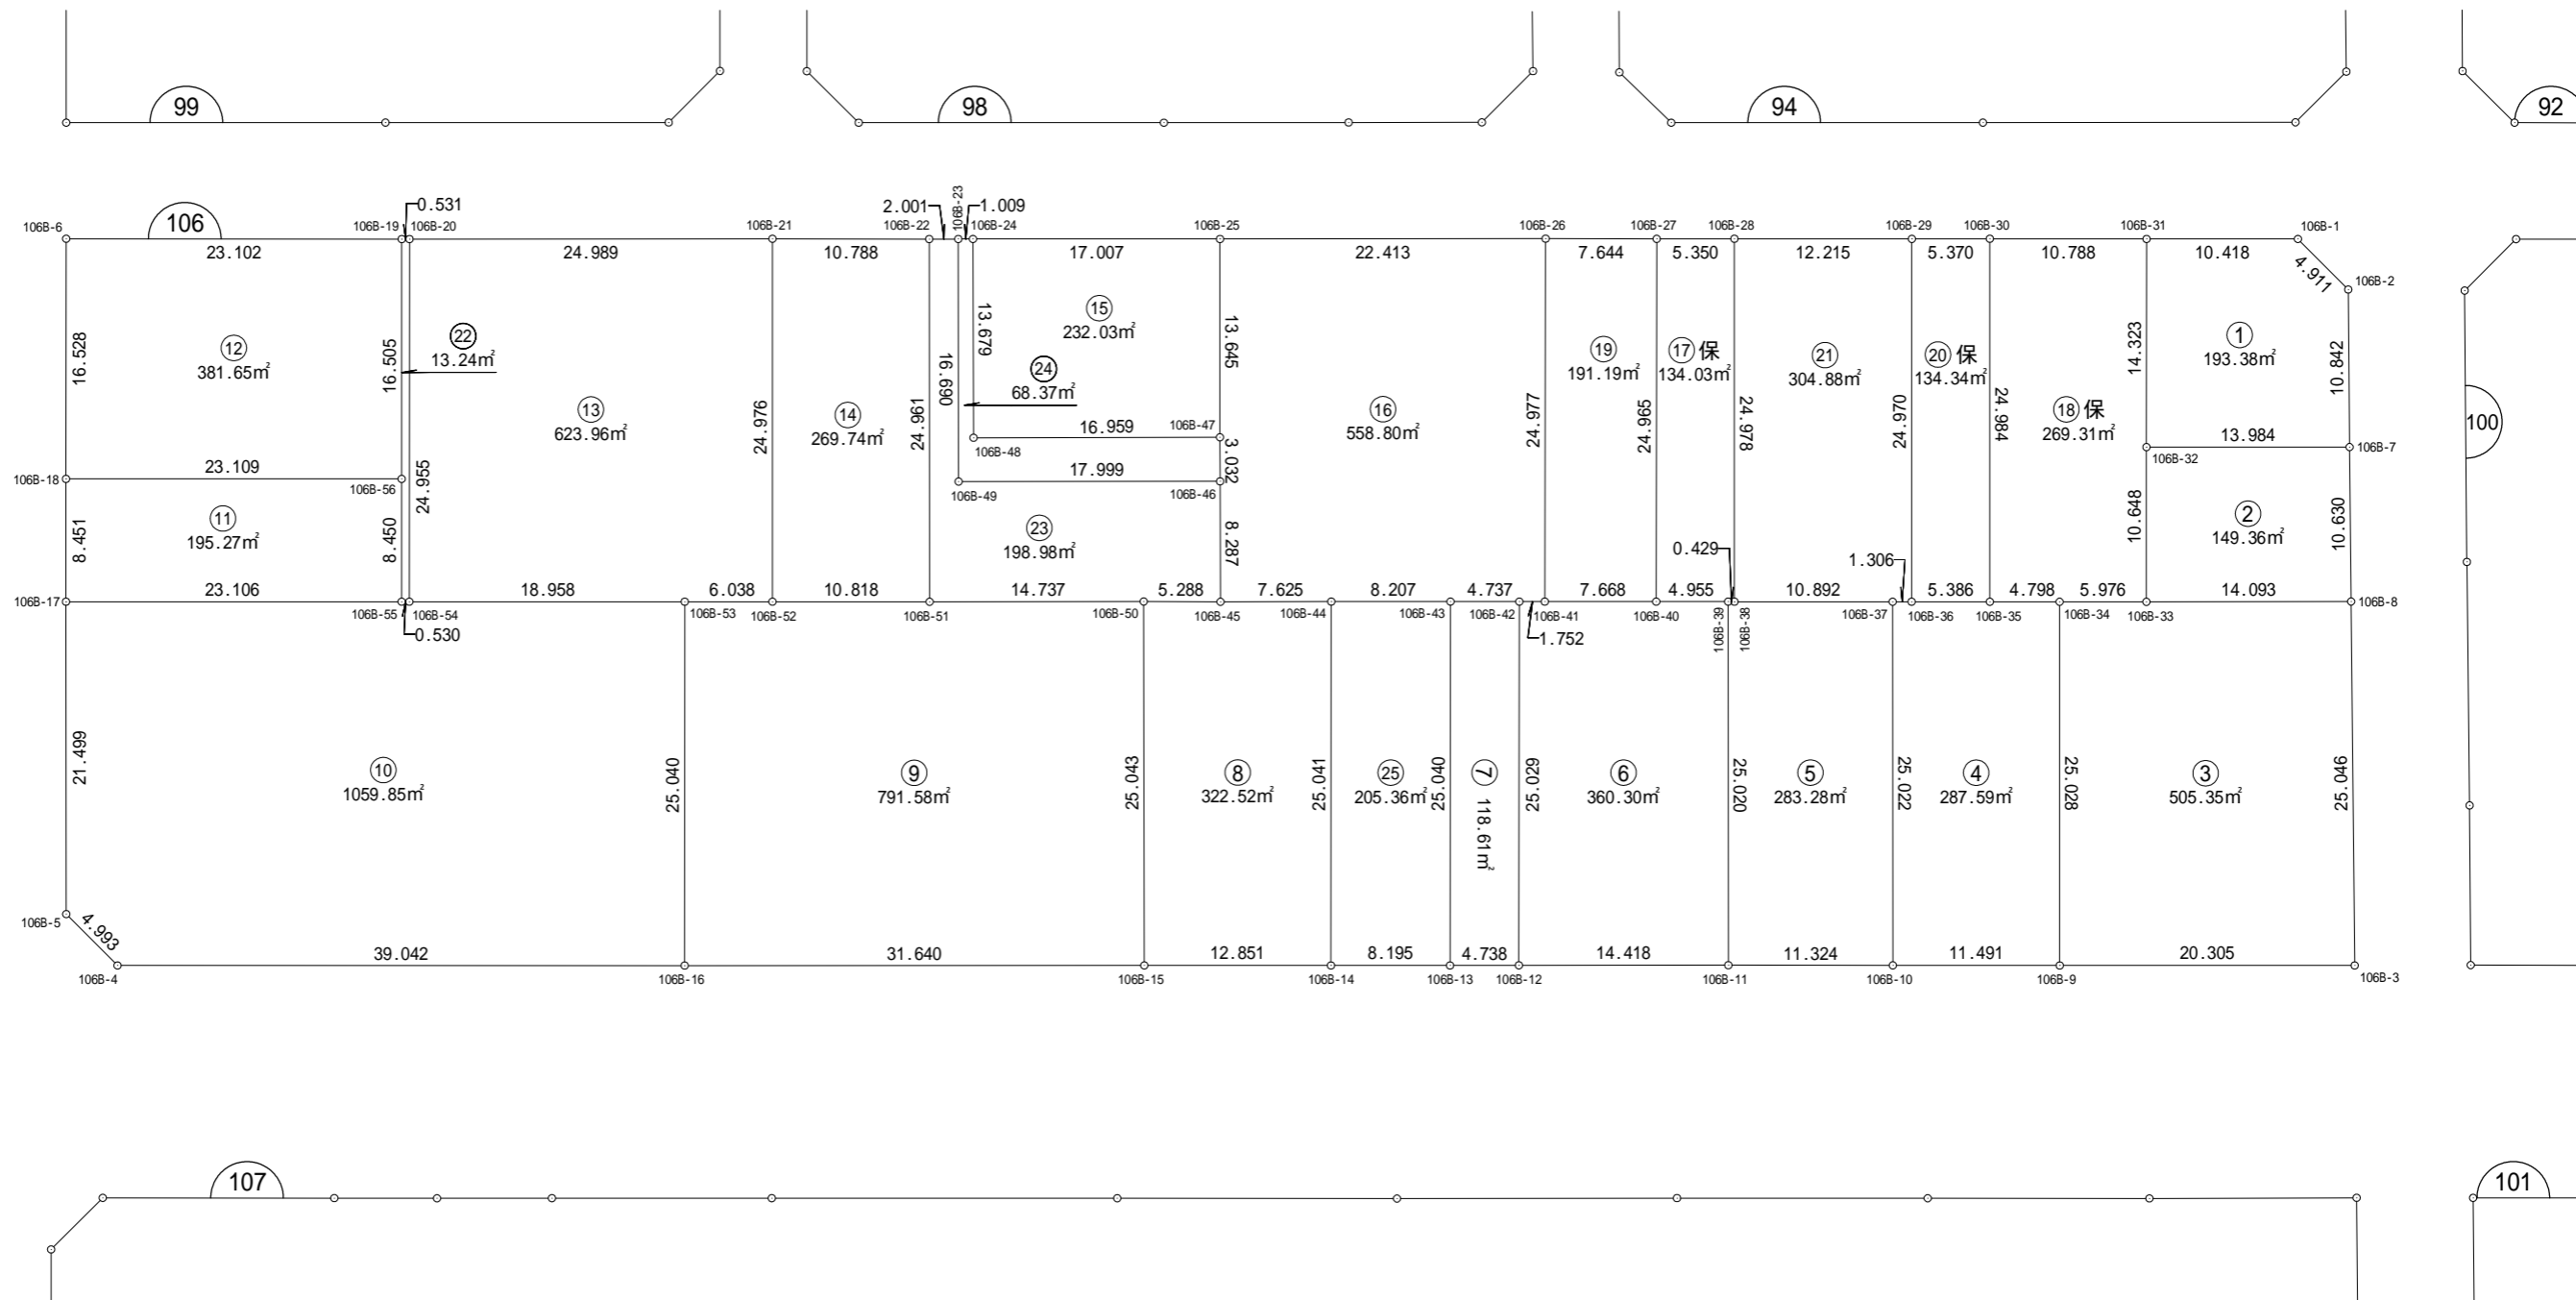


街区面積 4267.43

画地面積 4267.34

差 0.09

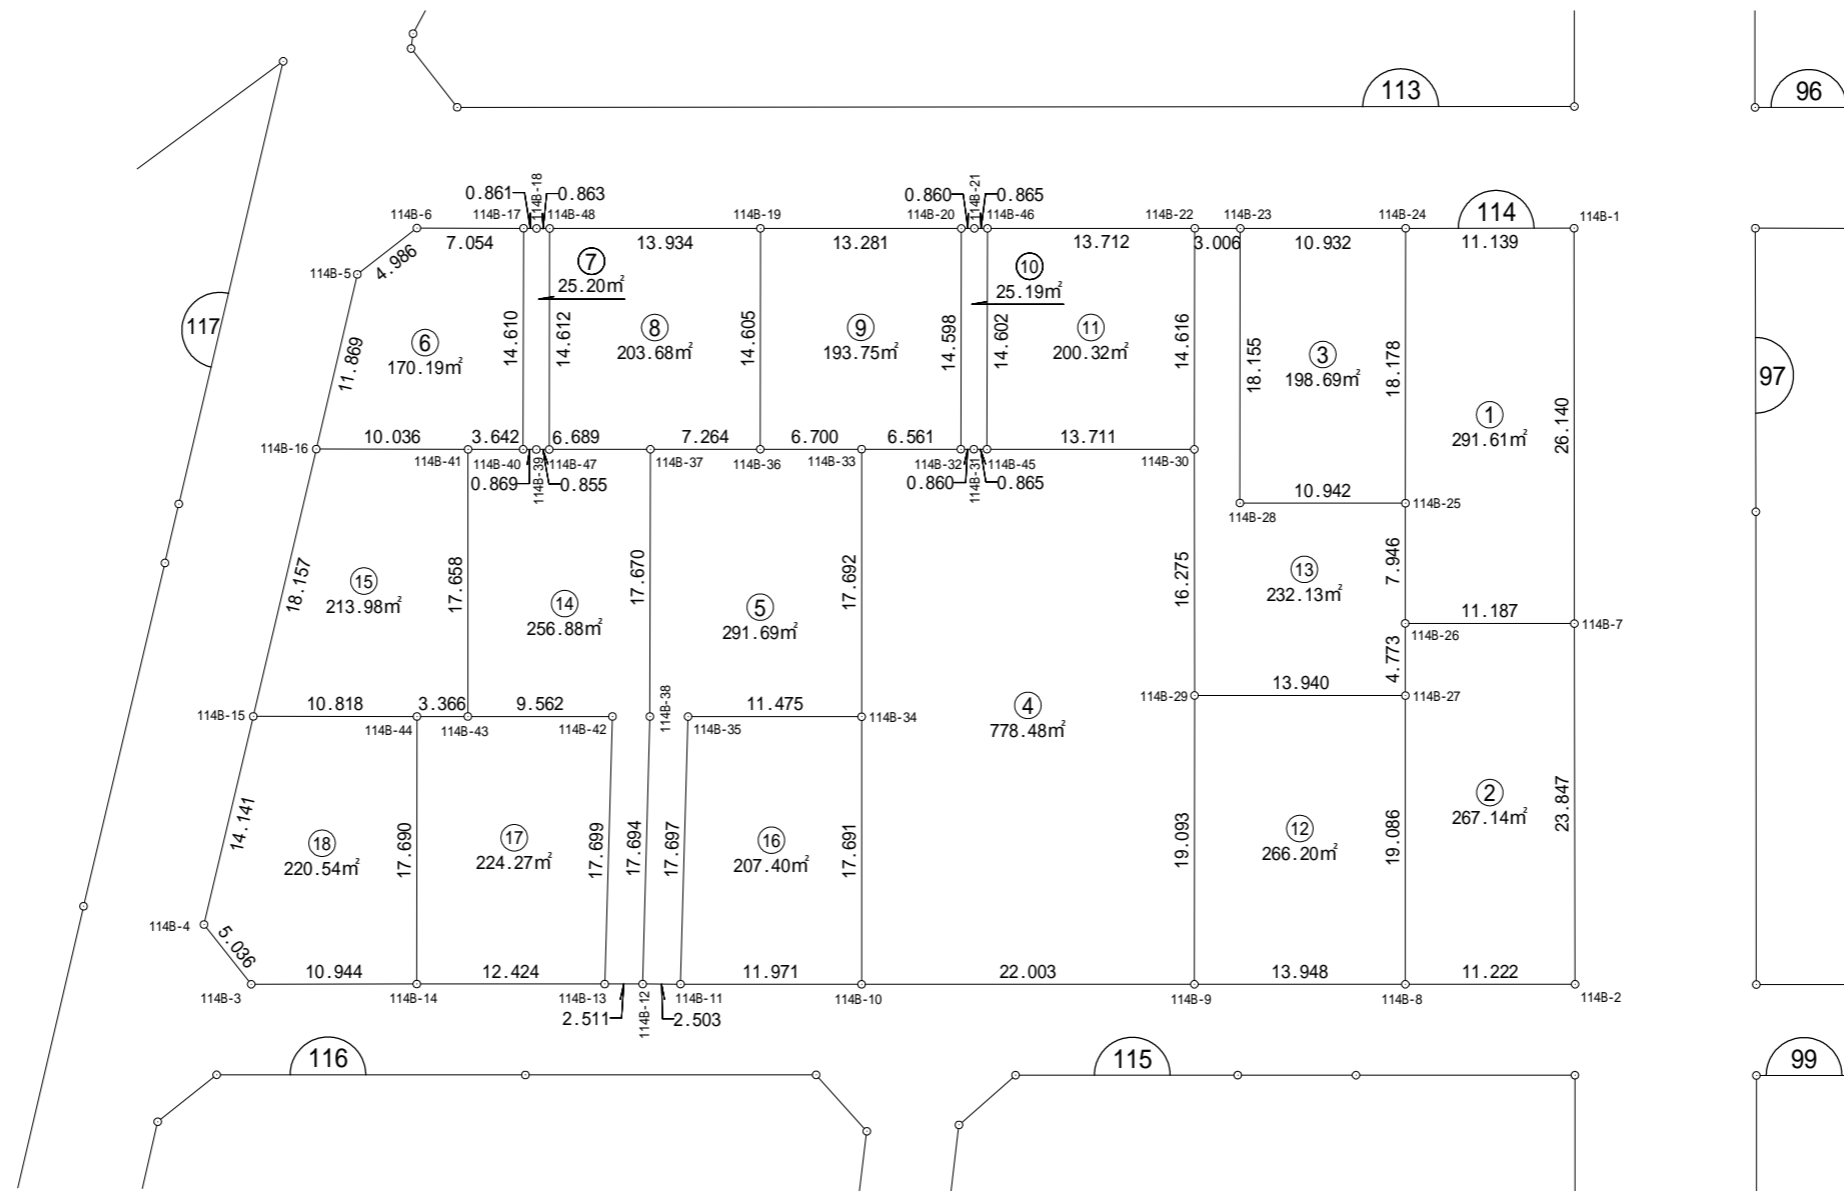



街区面積 7348.89
 画地面積 7348.75
 差 0.14

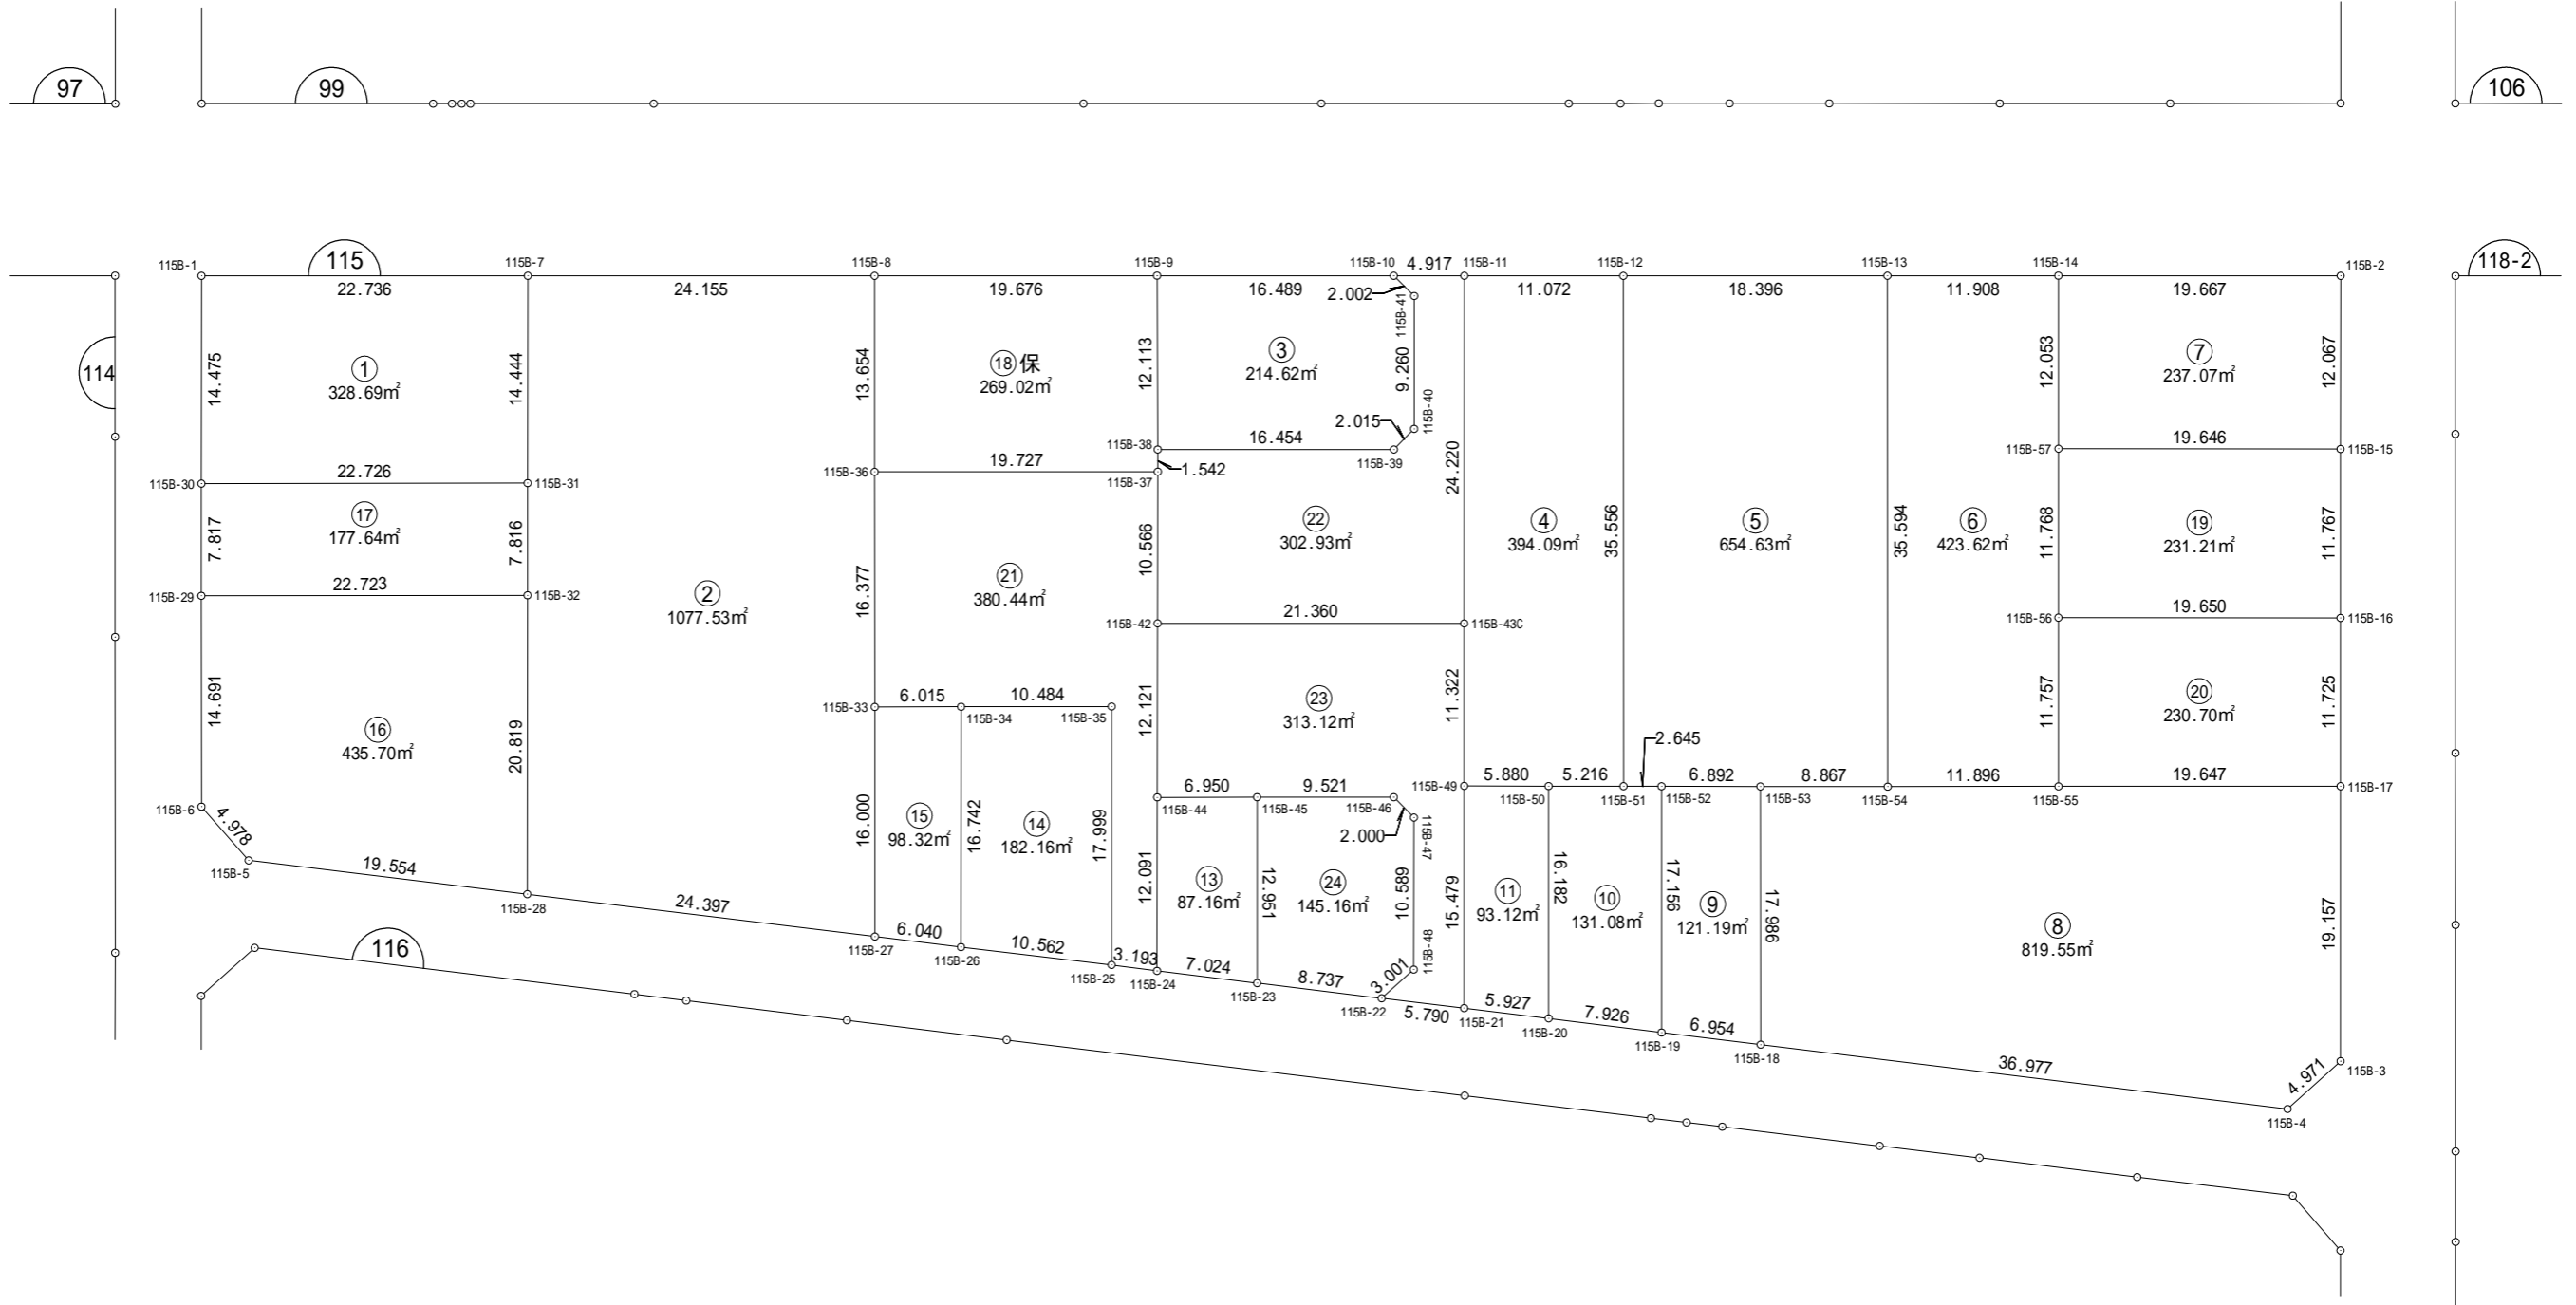

街区面積 8171.81

画地面積 8171.70


差 0.11

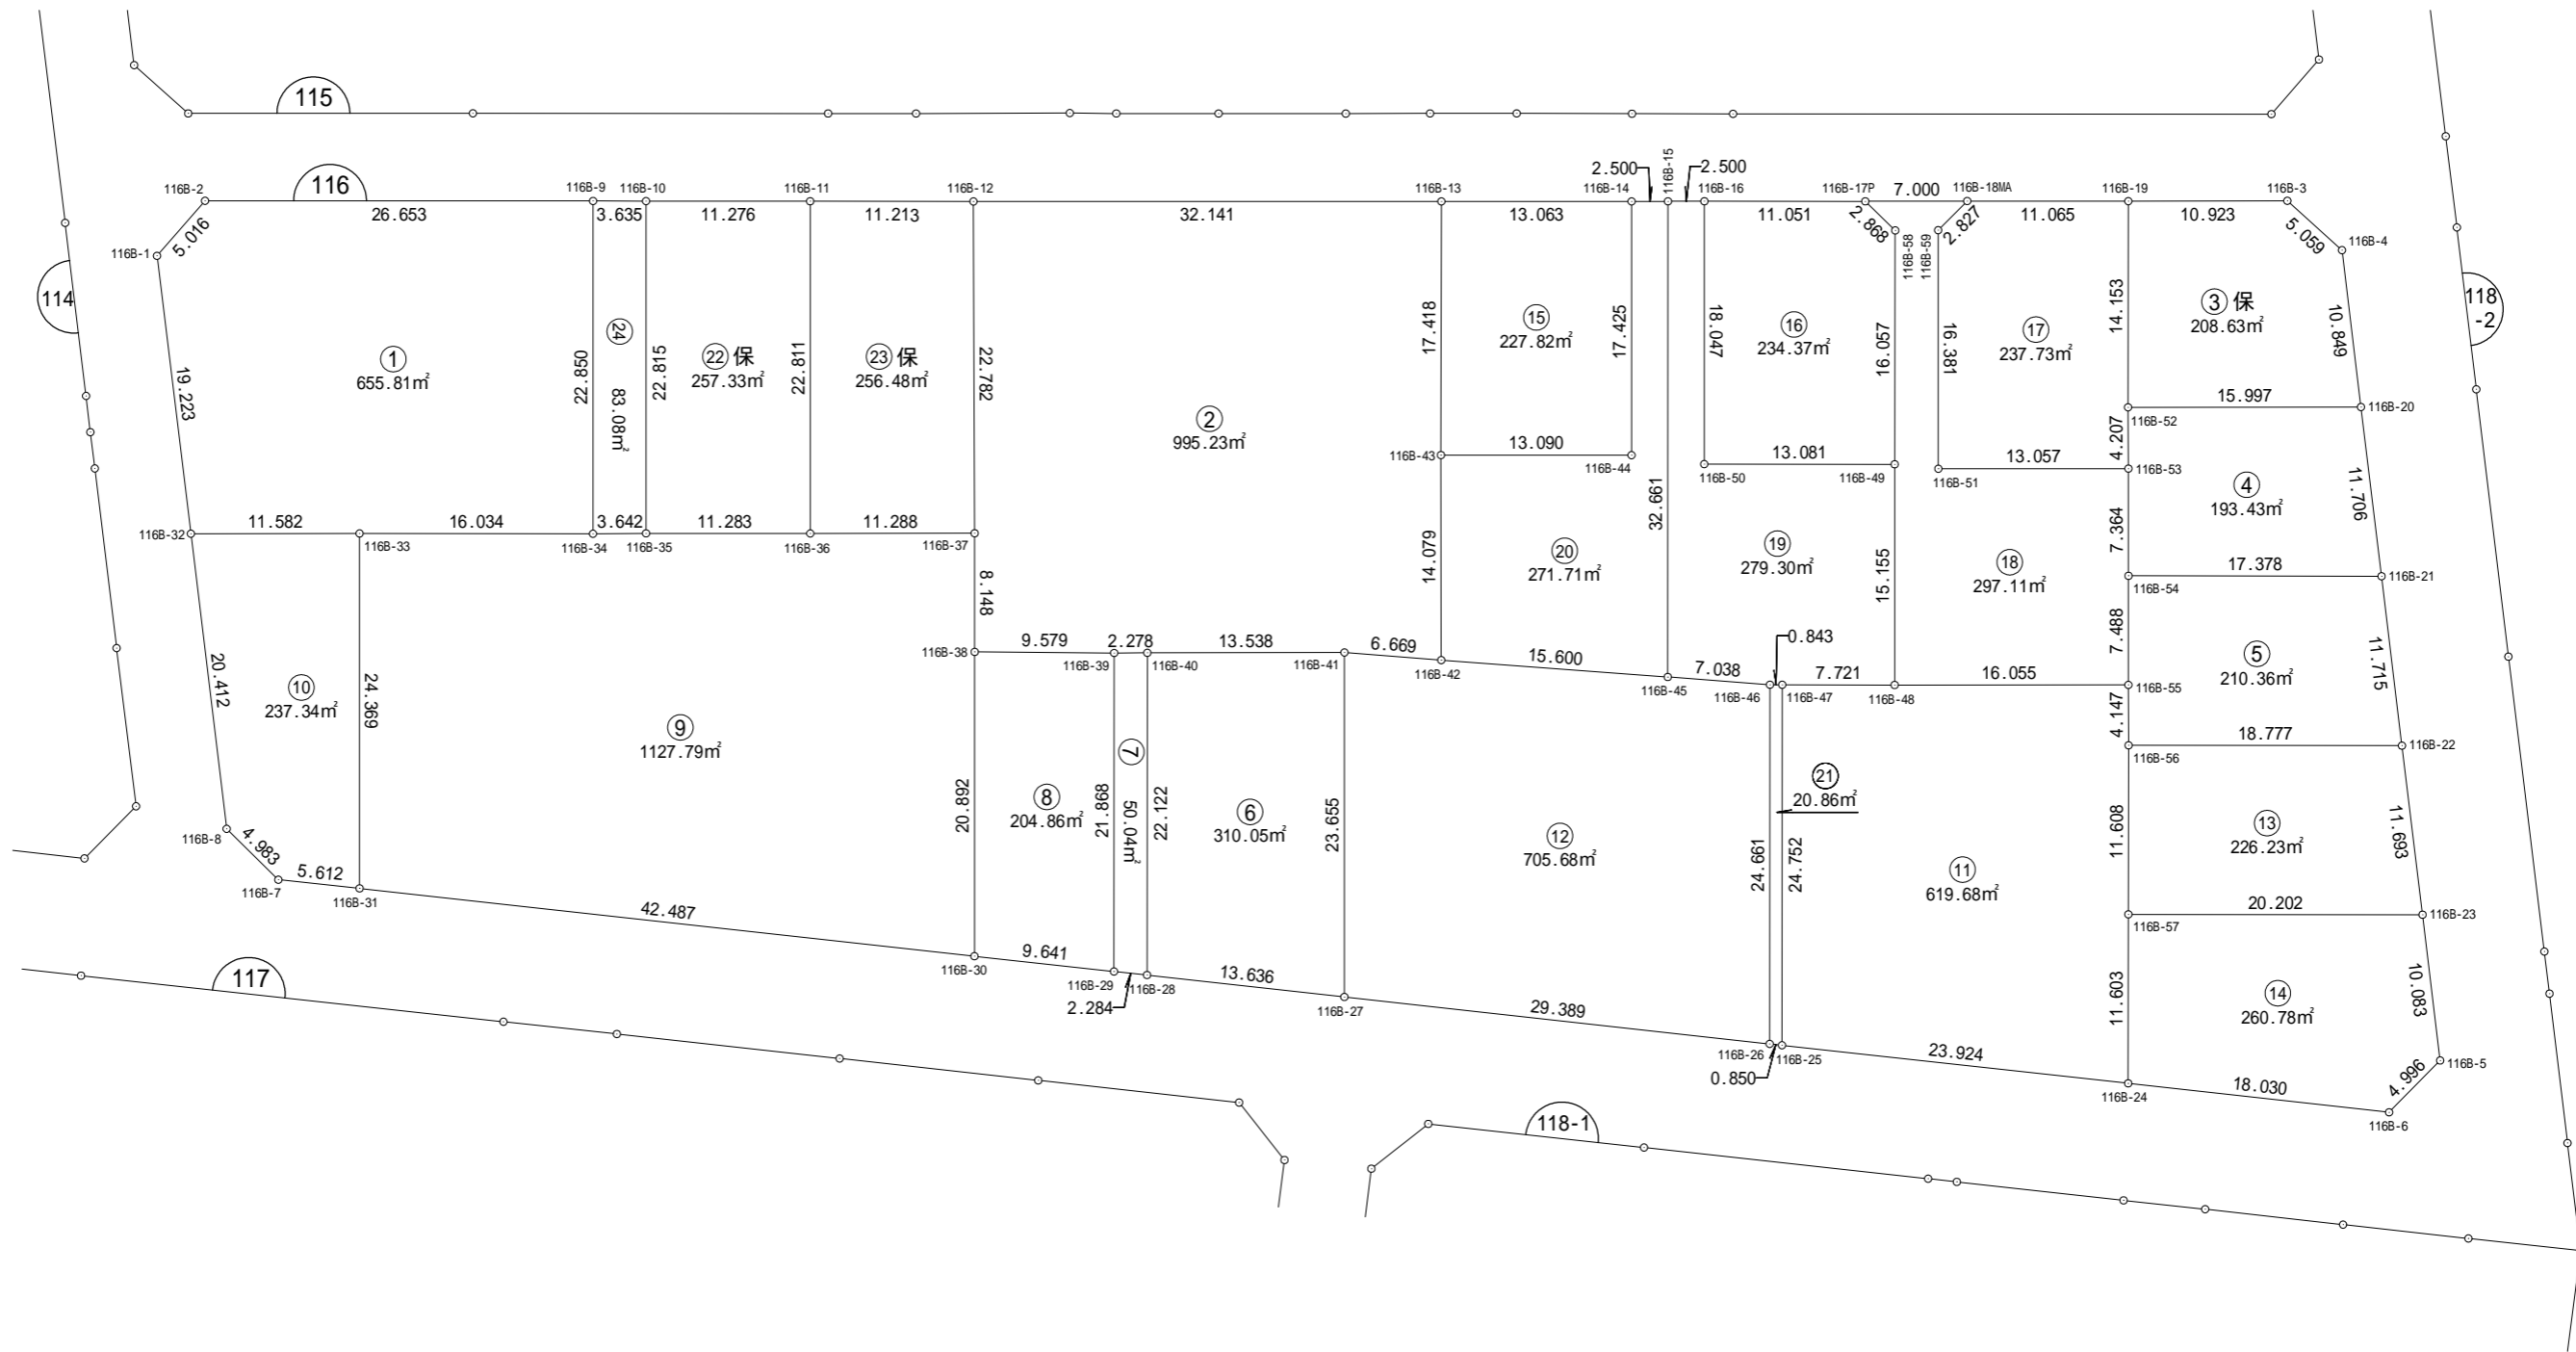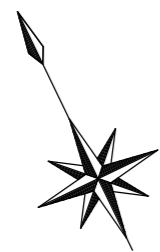


街区面積 5004.21


画地面積 5004.16

差 0.05

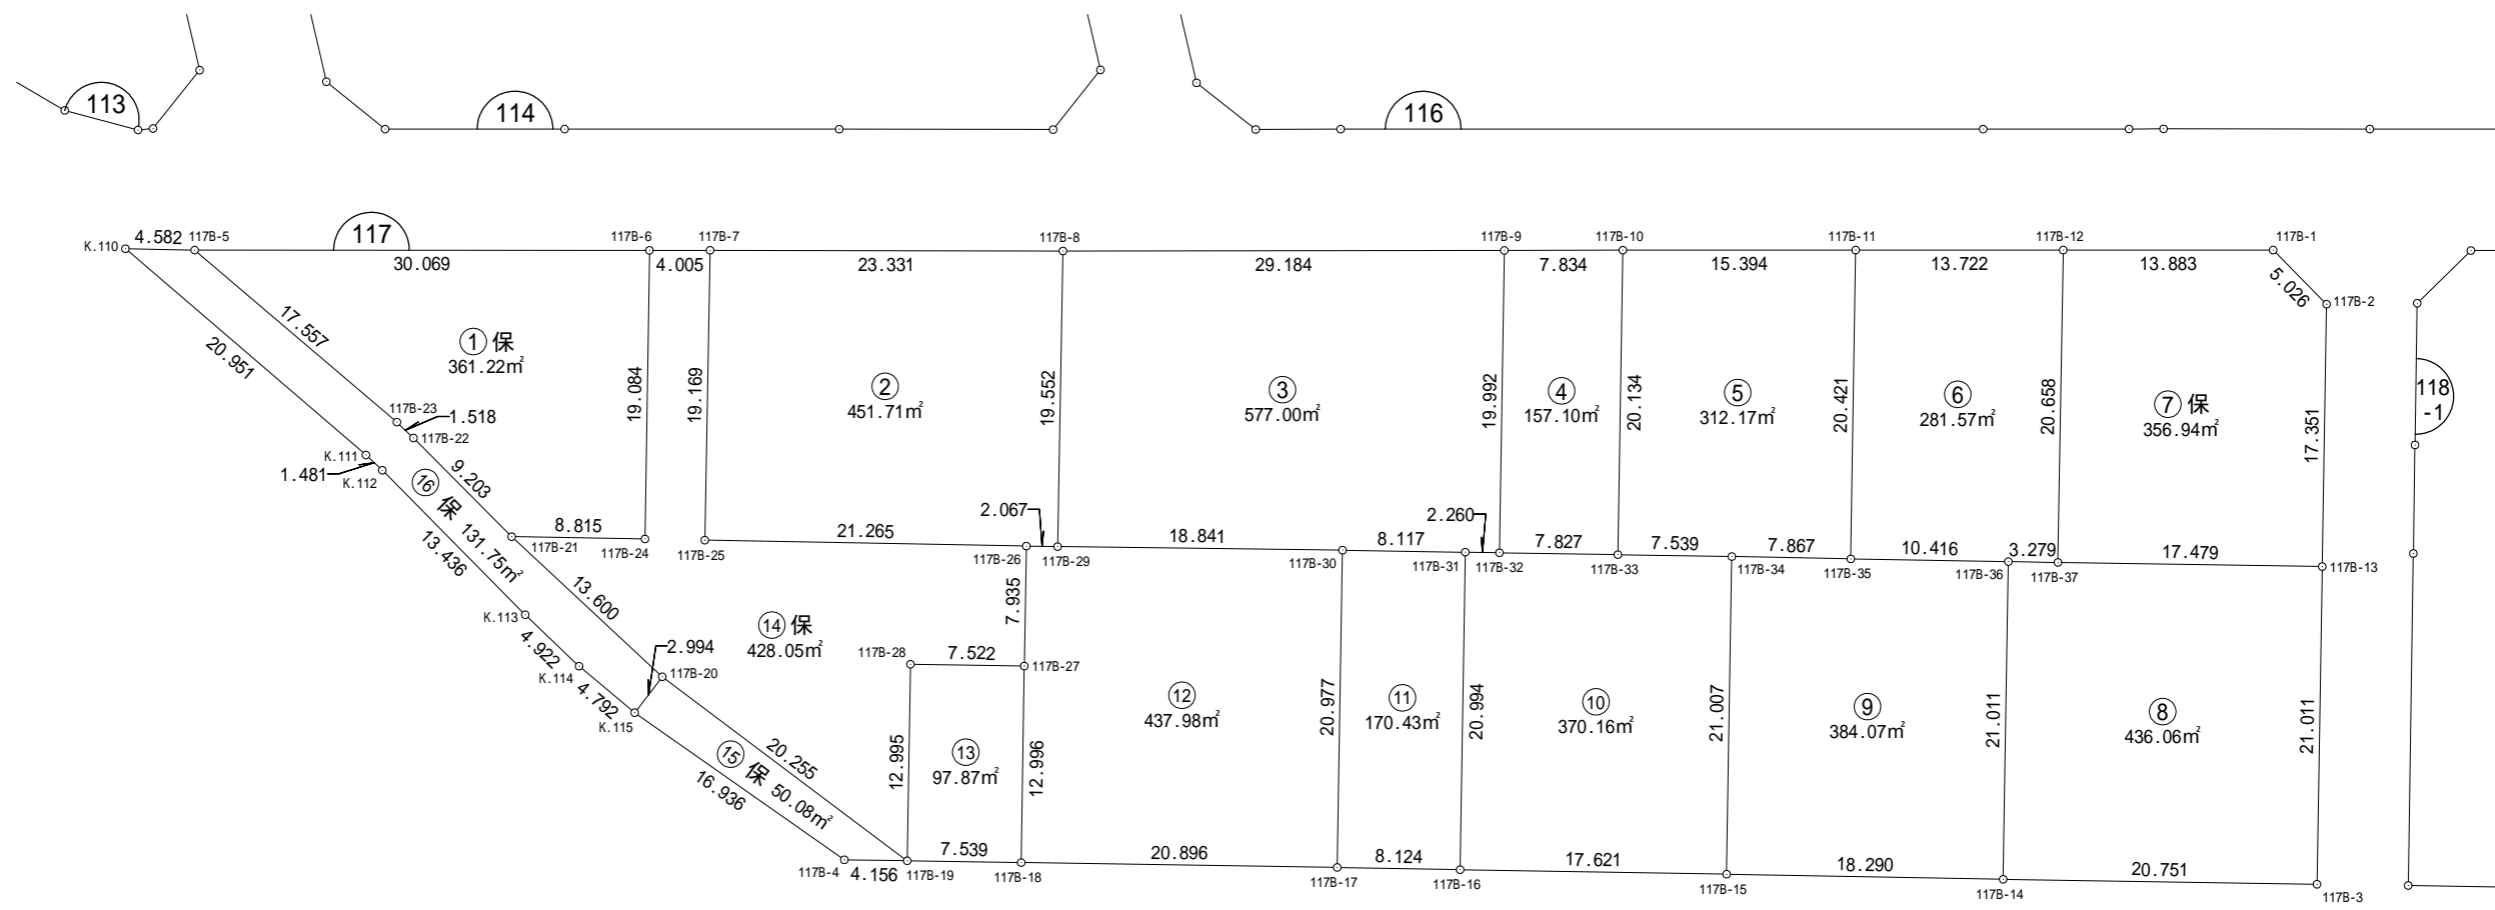

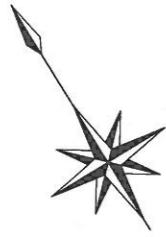

街区面積 3535.98
 画地面積 3535.92
 差 0.06

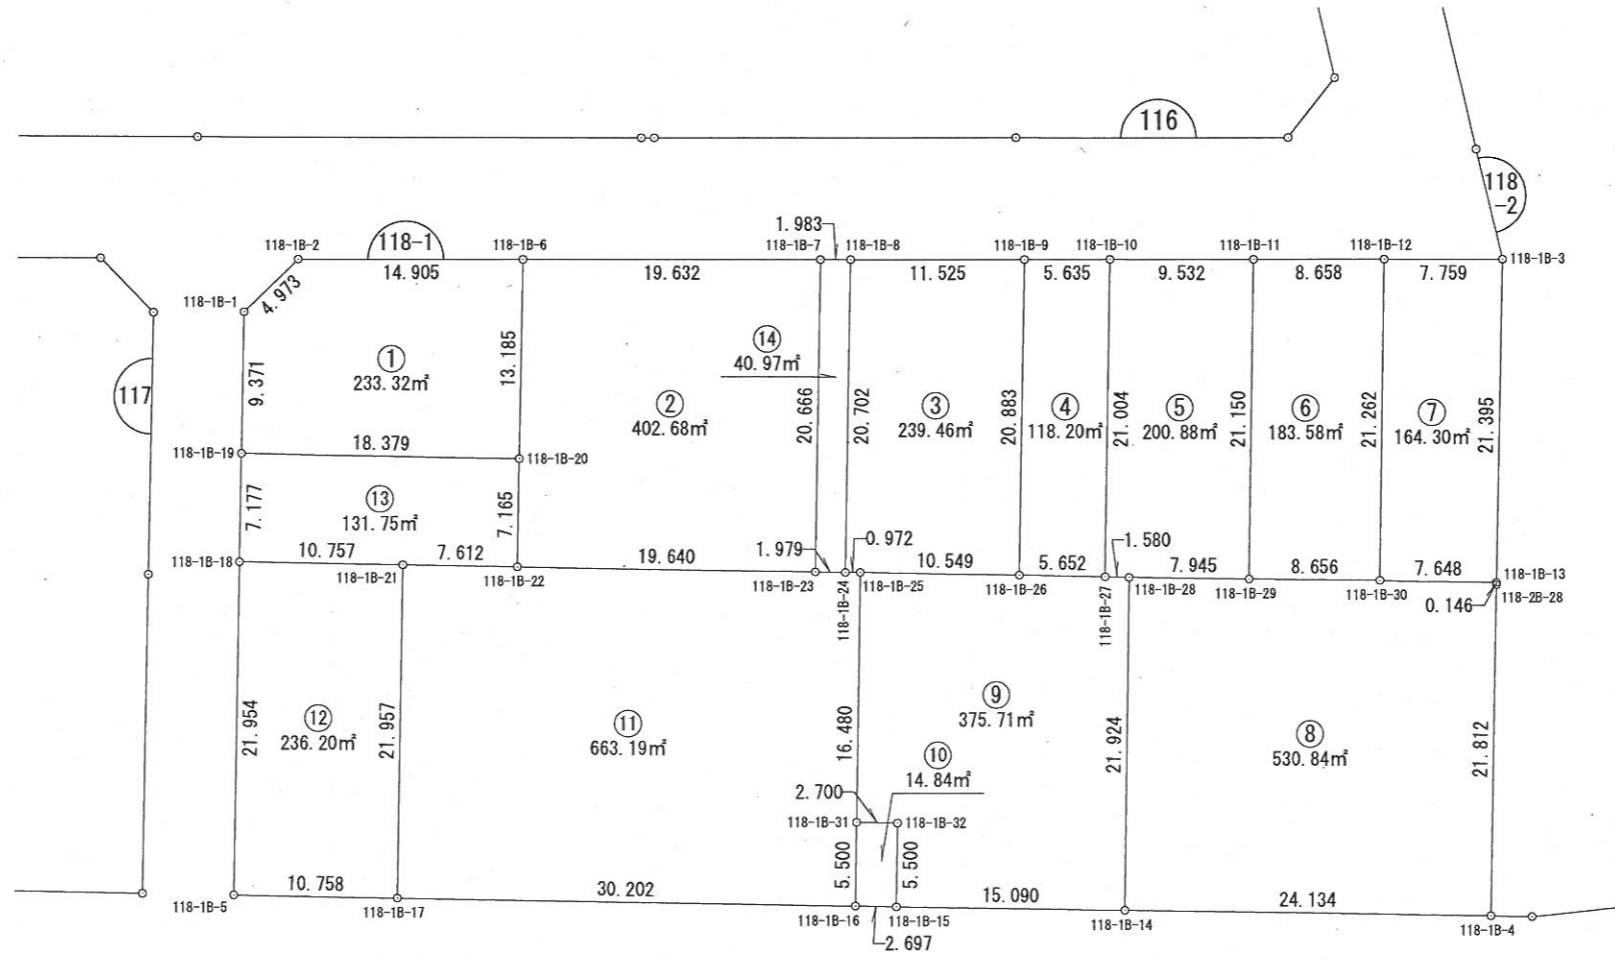

出来形確認測量図


街区番号 118-2BL

(1/2)

街区面積 9386.77

画地面積 9386.65

差 0.12

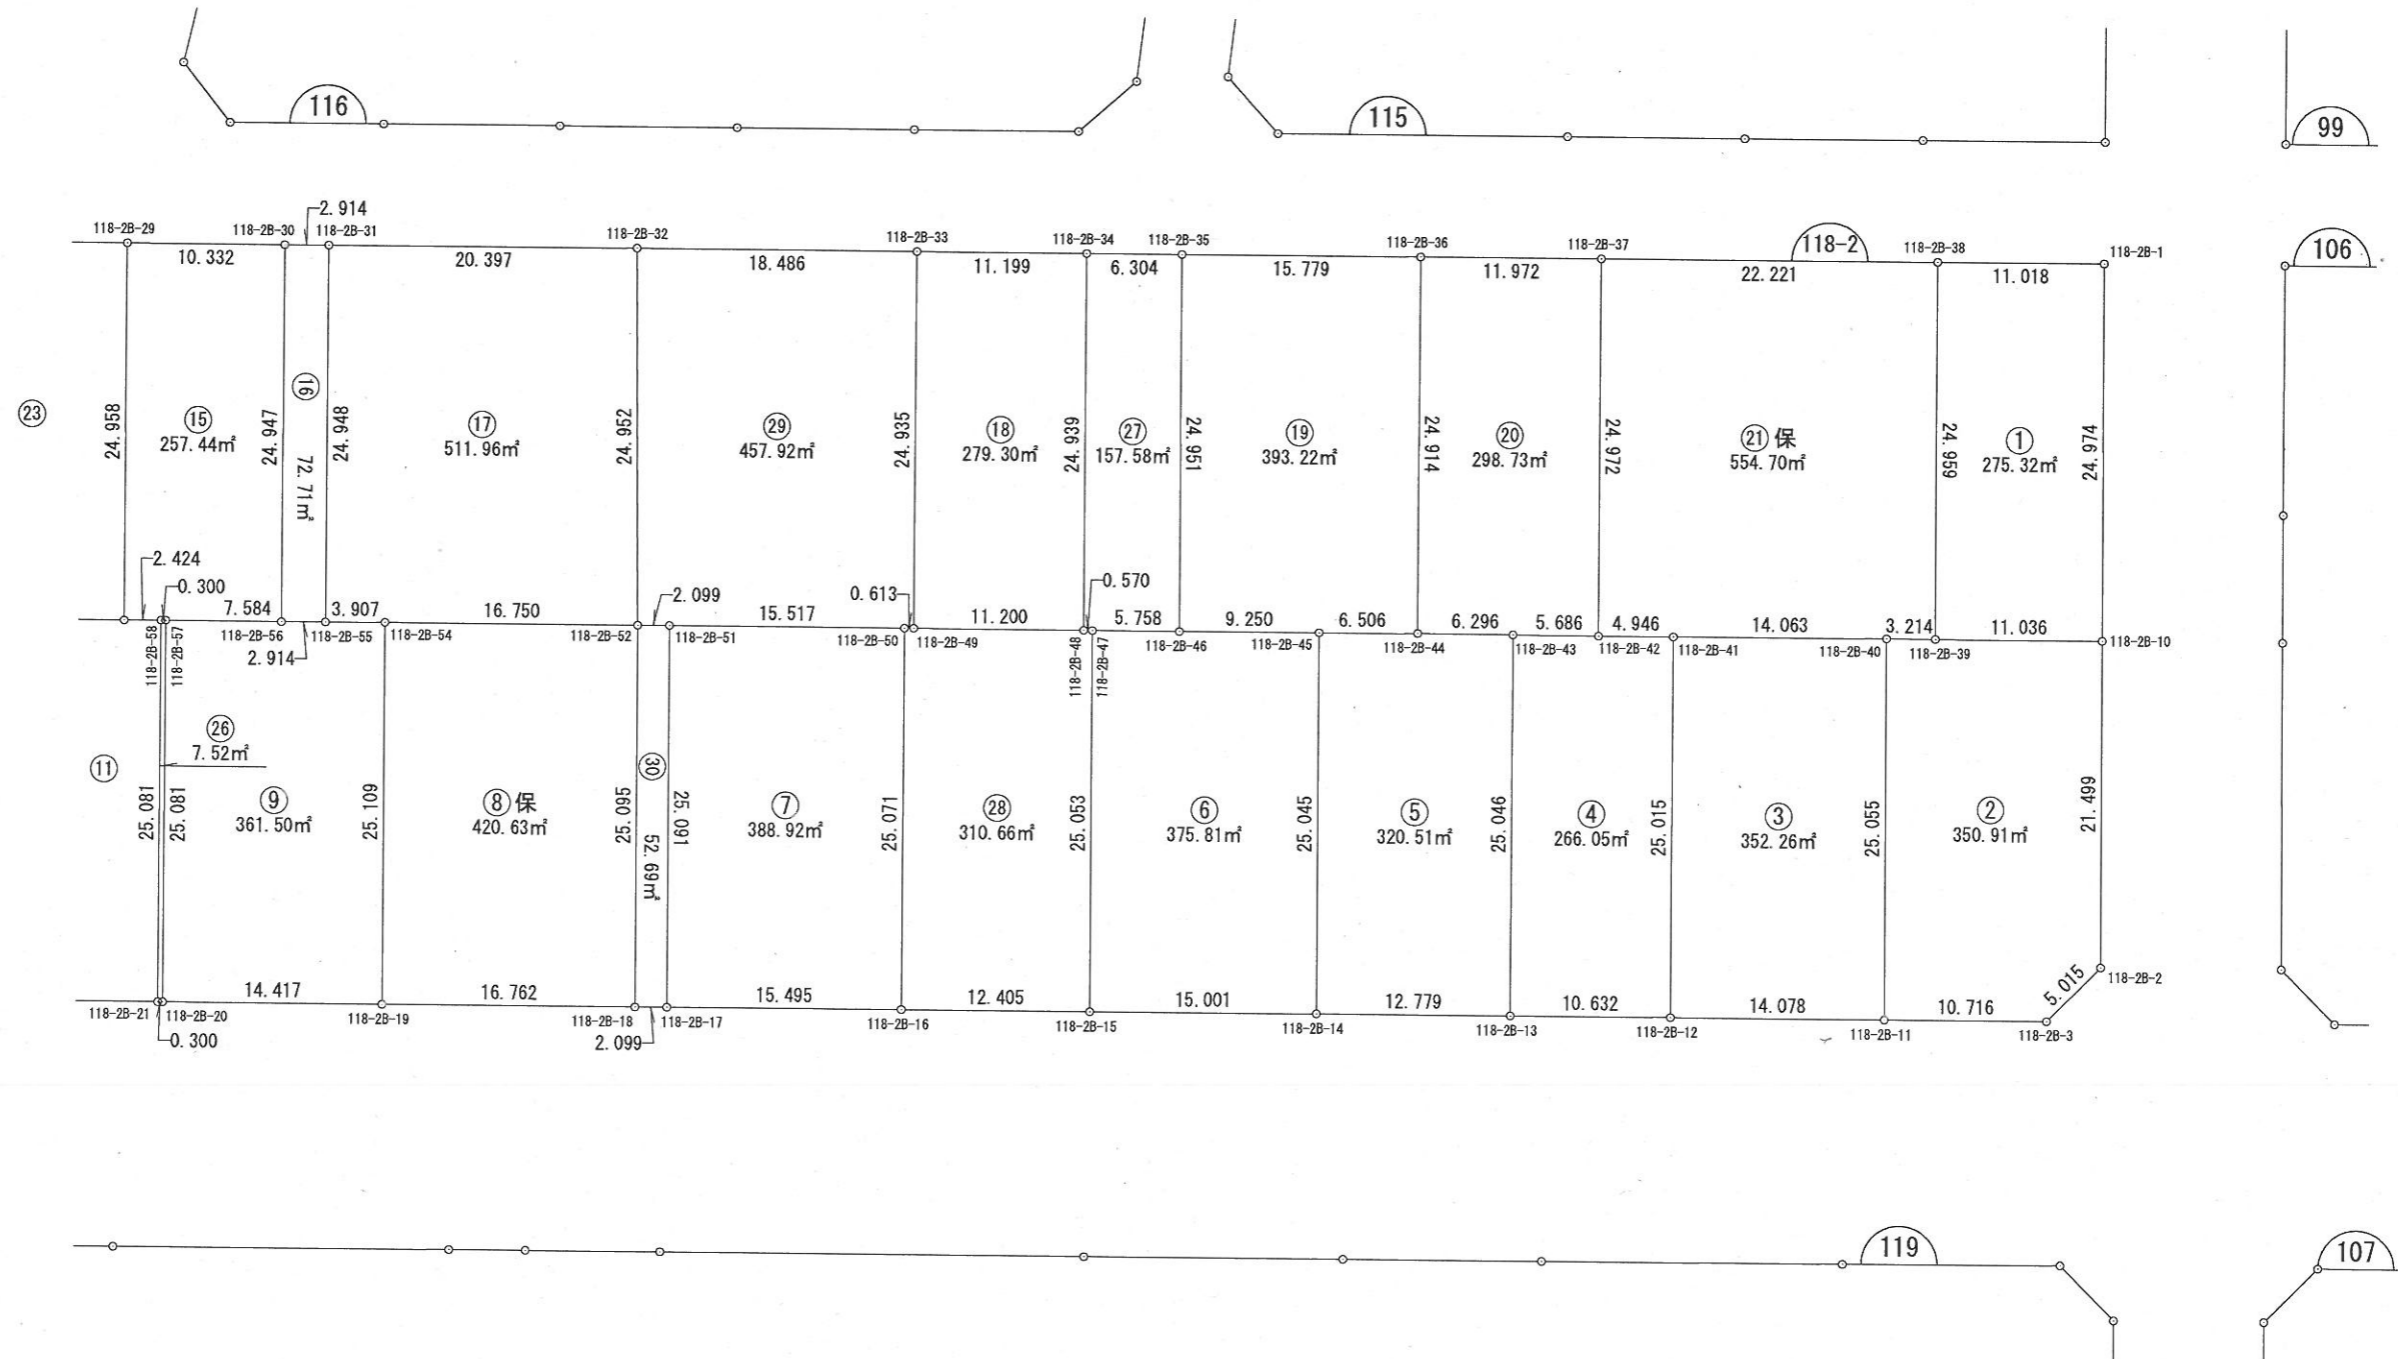

縮尺 1:500

街区面積 9386.77

画地面積 9386.65

差 0.12

